

ALTERNATE RESERVOIR APPLICATION MAP FOR VICTOR BAUMANN

RECEIVED

SEP 01 2015

WATER RESOURCES DEPT
SALEM, OREGON

Pond Location= ○


Streams

2035

Center of dam will be 1200 feet North and ~~1350~~ feet West of SE. corner of section 35.

Or Lat. 44 deg. 44' 28.8"N. , Long. 122 deg. 38' 58.6"W

Scale is one inch equals 600 feet..

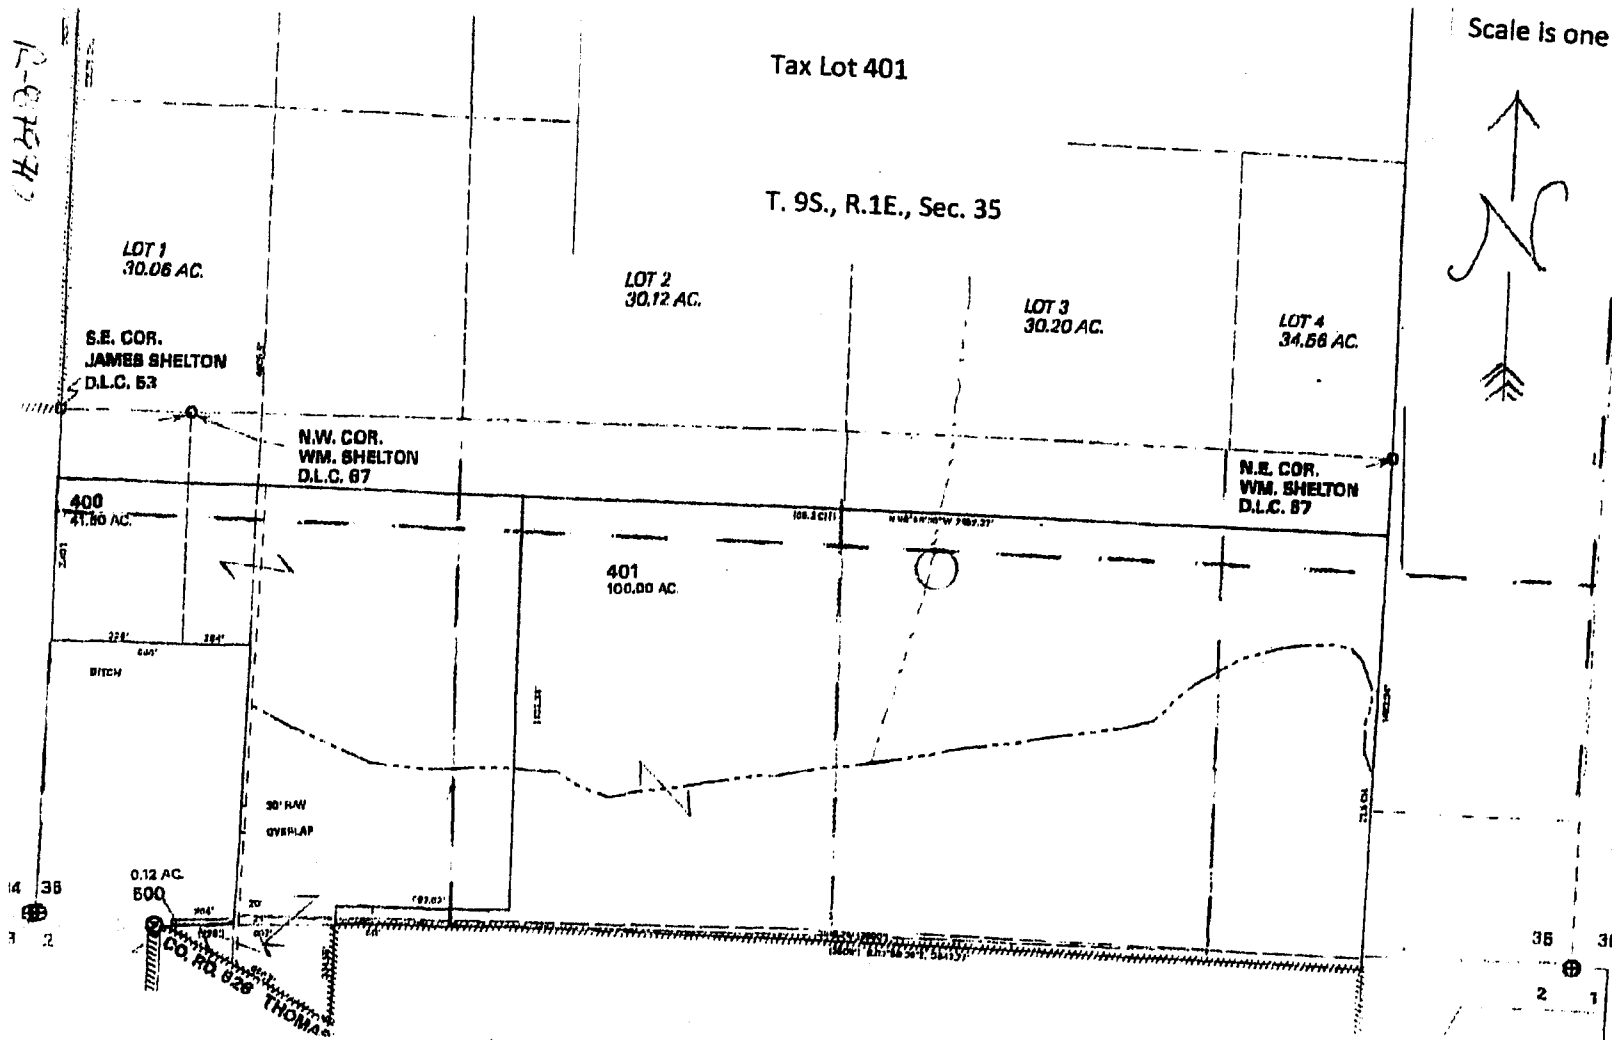

VICTOR BAUMANN
43967 Thomas Creek
Scio, Oregon 97374
503-859-3240