

App # R-85515  
 Permit # R-13647

LEGEND

LINE TYPES	
TAX LOT BOUNDARY	OLD PROPERTY LINE
ROAD RIGHT-OF-WAY	VACATED RIGHT-OF-WAY
RAILROAD	RAILROAD RIGHT-OF-WAY
STREAM, LAKE, ETC. TAX LOT BOUNDARY	STREAM, LAKE, ETC. NON-BOUNDARY
SUBDIVISION BOUNDARY	PARTITION PLAT BND.
TAX CODE BOUNDARY	EMBOWMENT

SYMBOL TYPES

DLC	
CONTROL POINTS	
SURVEY INSTRUMENTS	
S.A. CORNERS	
SECTION	
1/4 SEC	
1/16 SEC	
1/32 SEC	

NUMBERS

TAX CODE NO.  
 000 00 00 0


ACRES - ALL ACRES INCLUDING ANY PORTION THAT MAY LIE WITHIN THE DISCRETE PUBLIC RIGHT OF WAY.

TICK MARKS - WHEN A TICK MARK IS DISPLAYED ON THE EXTENSION OF A LINE, THEN THE DIMENSION GOES TO THE TICK MARK. OTHERWISE THIS IS USED WHEN DIMENSIONS GO INTO PUBLIC RIGHT OF WAY.



ARROWS ARE USED WITH DIMENSIONS IN AREAS OF GREATER COMPLEXITY.

NOTICE: This map was created for Assessor's Office use ONLY.

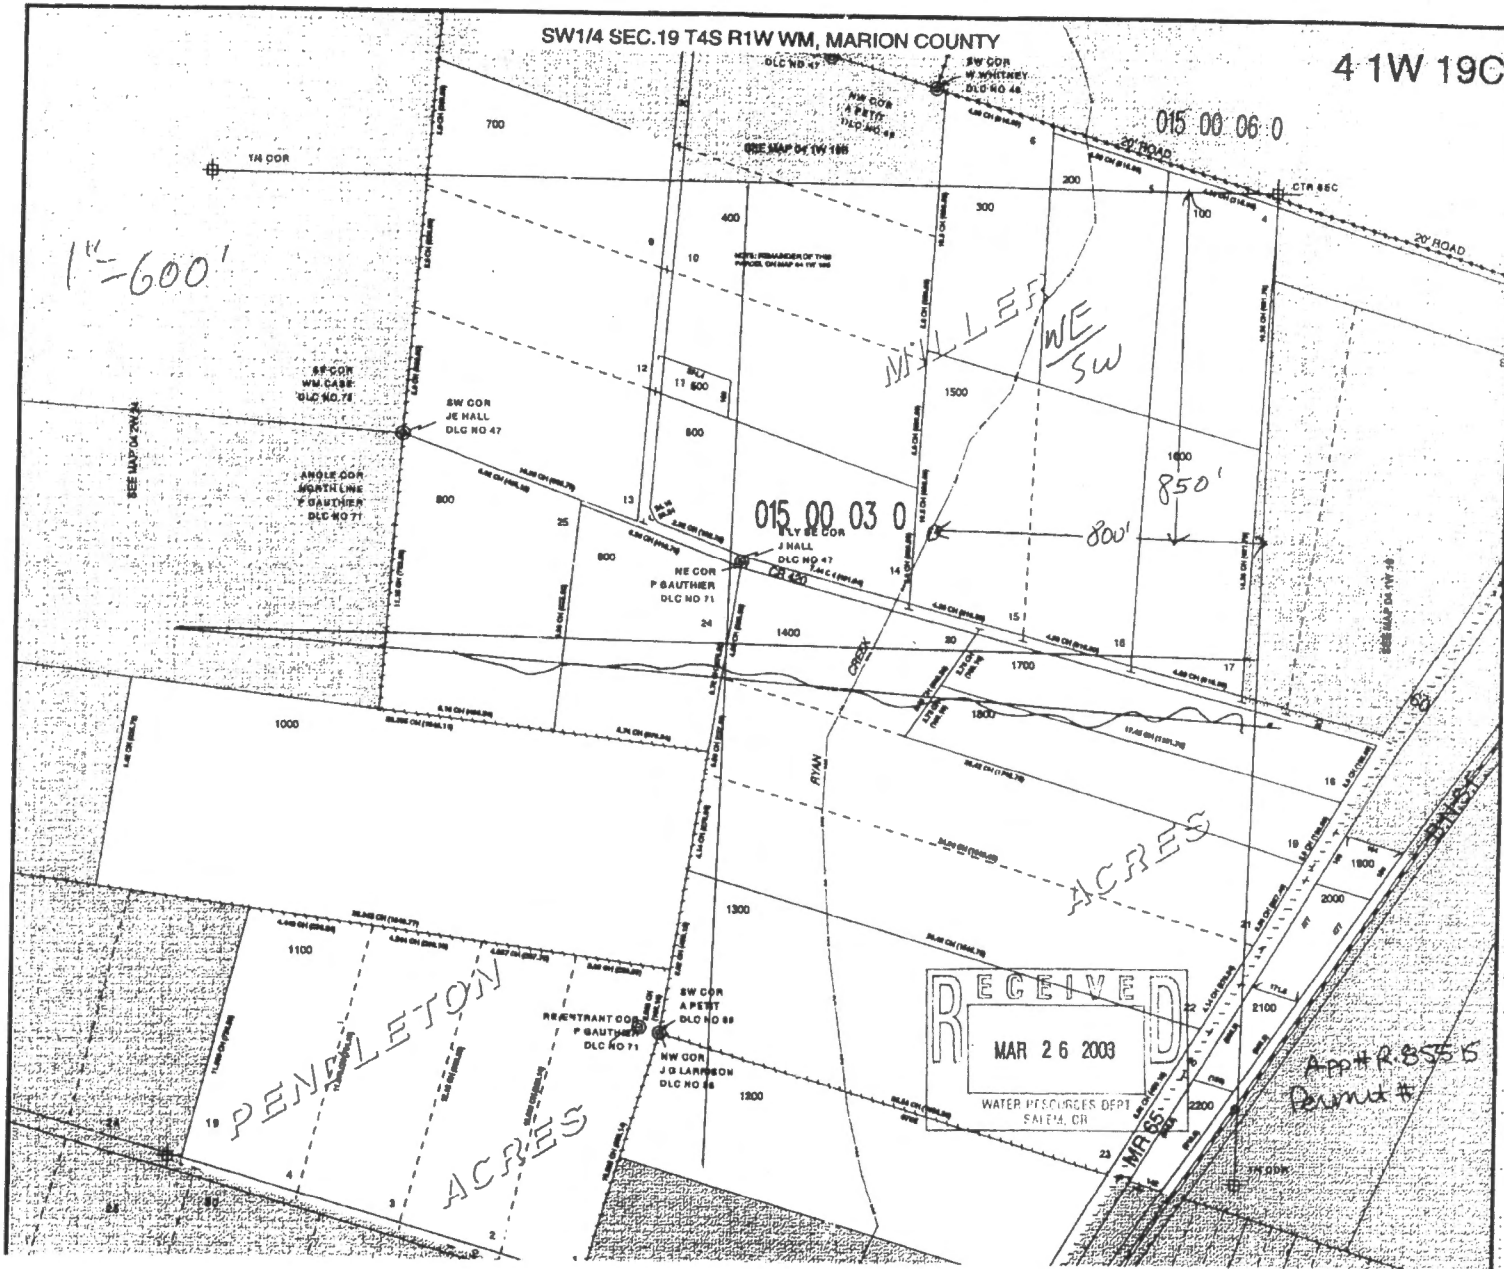

RECEIVED BY OWRD

AUG 31 2015

SALEM, OR