


T5S R23E TL 2400
Harrison Canyon Reservoir Permit R-13287

1 inch = 1,320 feet

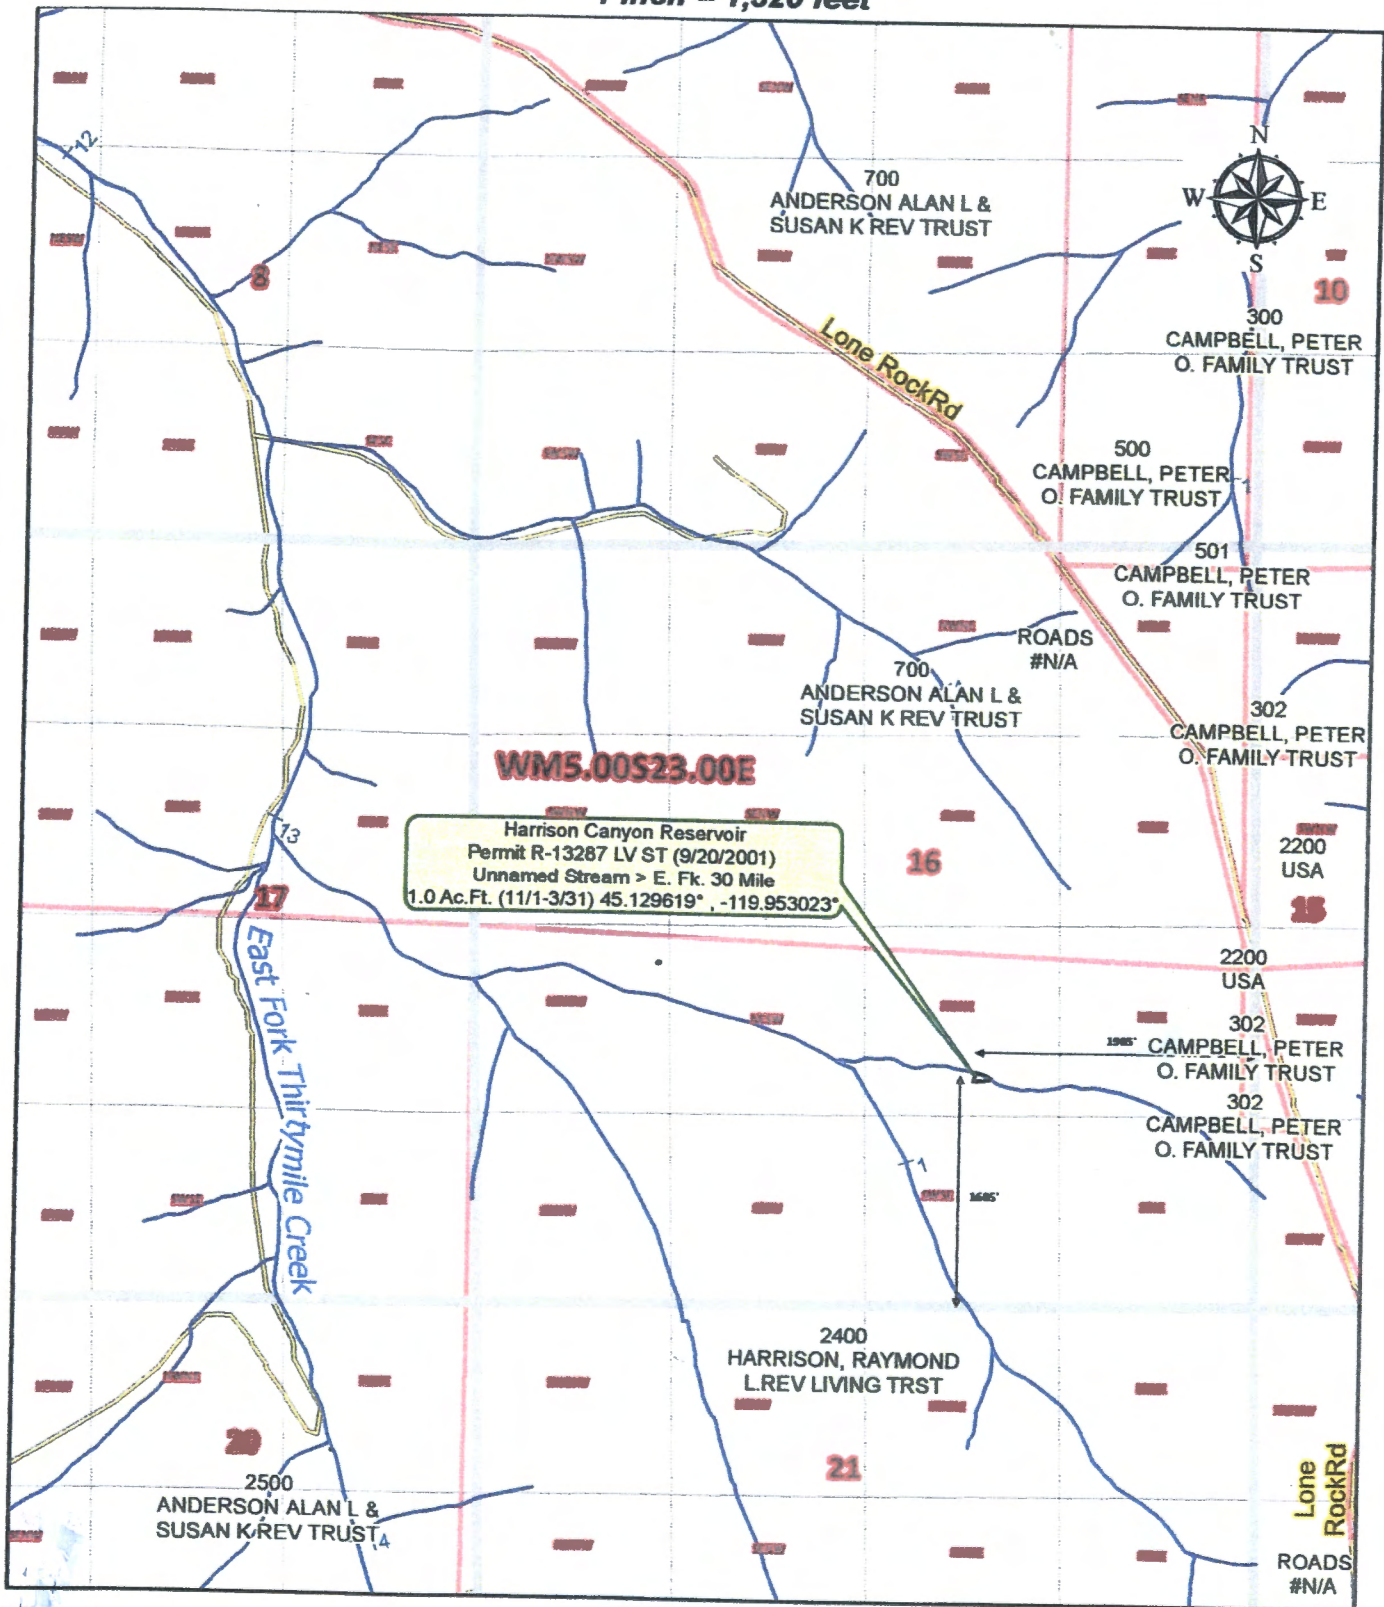

Harrison Canyon Reservoir
 5.00S-23.00E-16-NW SE
 1605' N, 1905' E from SW Cor., Sec. 16

RECEIVED BY OWRD

JUL 01 2015

SALEM, OR

This map has been amended by OWRD
 to correct the direction of Harrison
 Canyon Reservoir. *W*
ce 7-11-16