

PLC (ADJ) MEASURED FROM THE


1600 FT SOUTH AND 2910 FT WEST

1560 FT SOUTH AND 2840 FT WEST

1530 FT SOUTH AND 2775 FT WEST

1540 FT SOUTH AND 2650 FT WEST

25 FEB 2005
Karin Hoffman

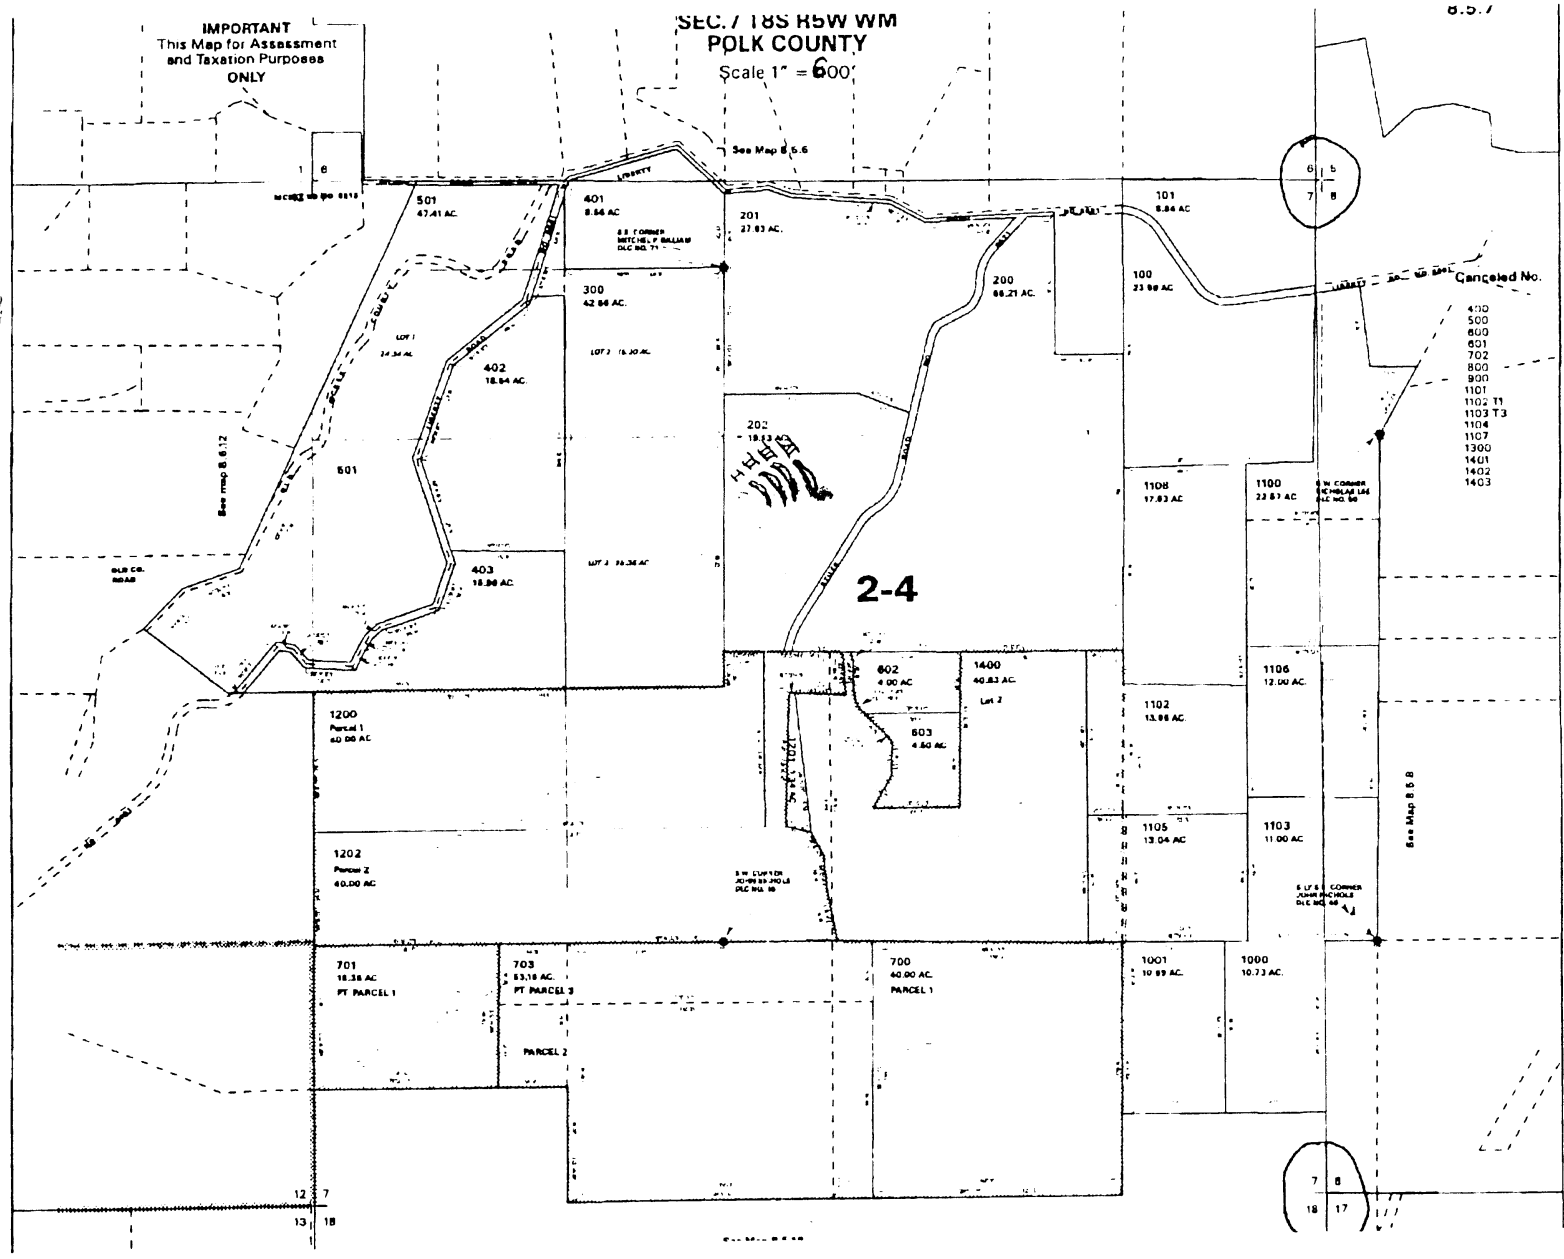

app R 86180

SALEM, OR

OCT 05 2015

RECEIVED BY OWRD