


PLZ (0200) MEASURE FROM THE WEST LINE

- I 1600 FT SOUTH AND 2910 FT WEST
- II 1560 FT SOUTH AND 2840 FT WEST
- III 1530 FT SOUTH AND 2775 FT WEST
- IV 1540 FT SOUTH AND 2650 FT WEST

*Kim Hillman* 25 FEB 05

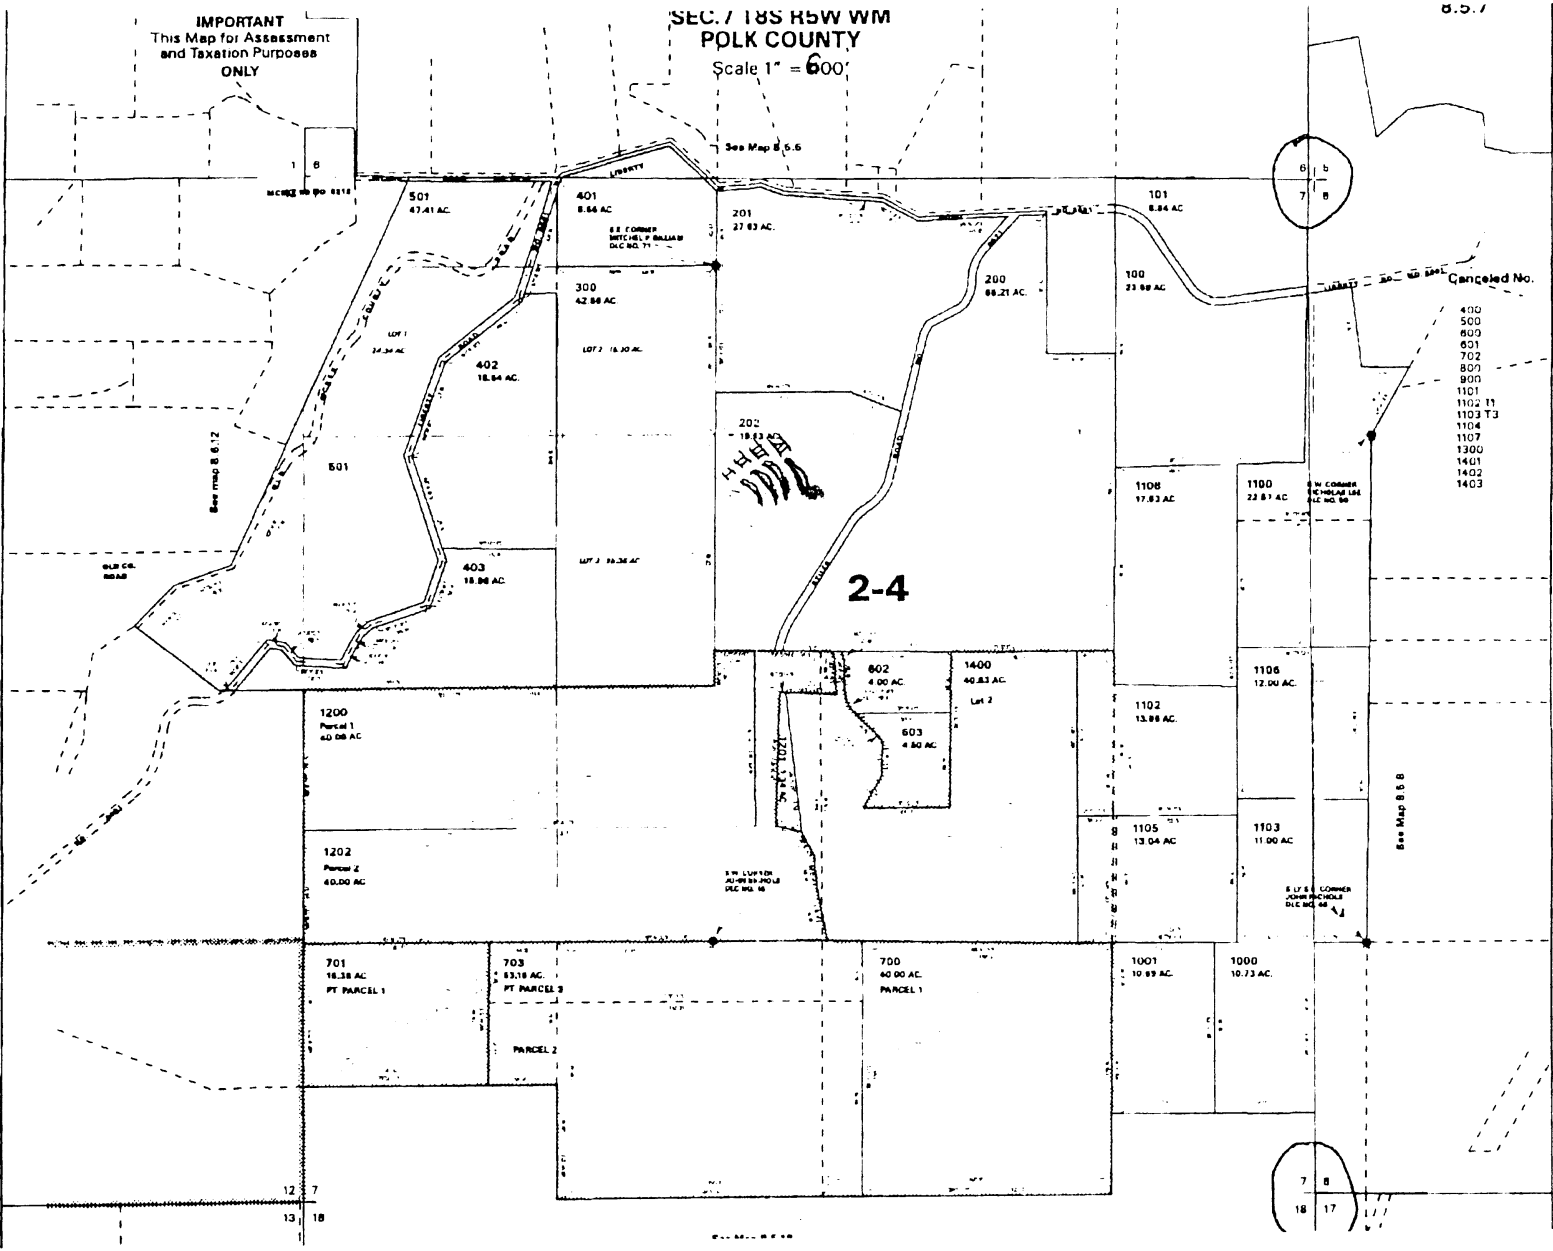

R 8198 # app

SALEM, OR

OCT 05 2015

RECEIVED BY OWRD