


#3

Matthews Small Ponds Application

T 1 S, R 38 E, Section 15

11-5

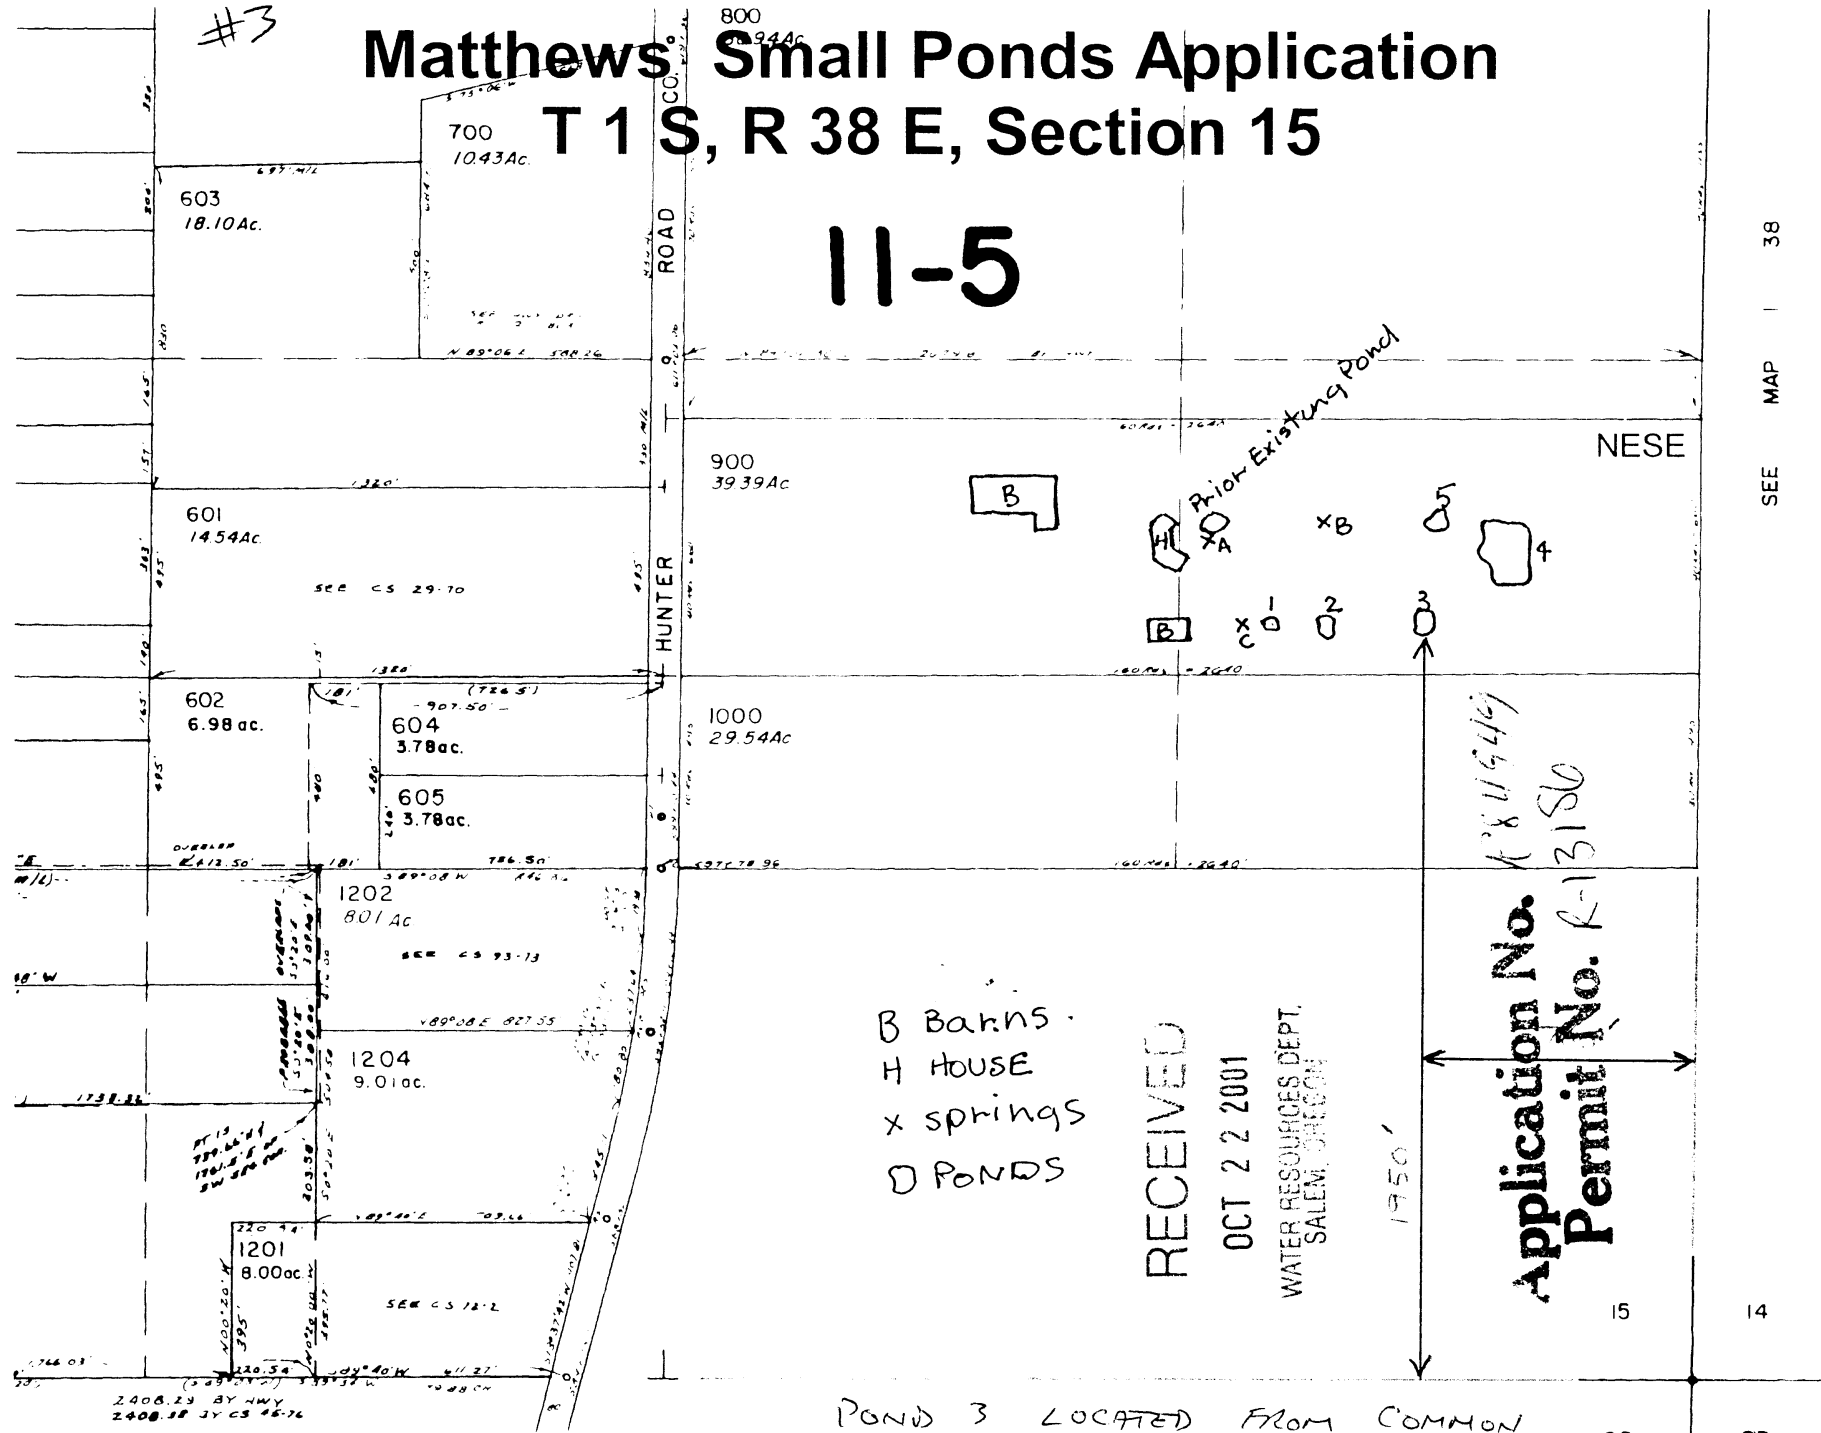

Scale 1" = 500'

POND 3 LOCATED FROM COMMON
SECTION CORNER 14, 15, 22, 23

700' WEST & 1950' NORTH

SEE MAP | 38

