


Matthews Small Ponds Application

T 1 S, R 38 E, Section 15

11-5

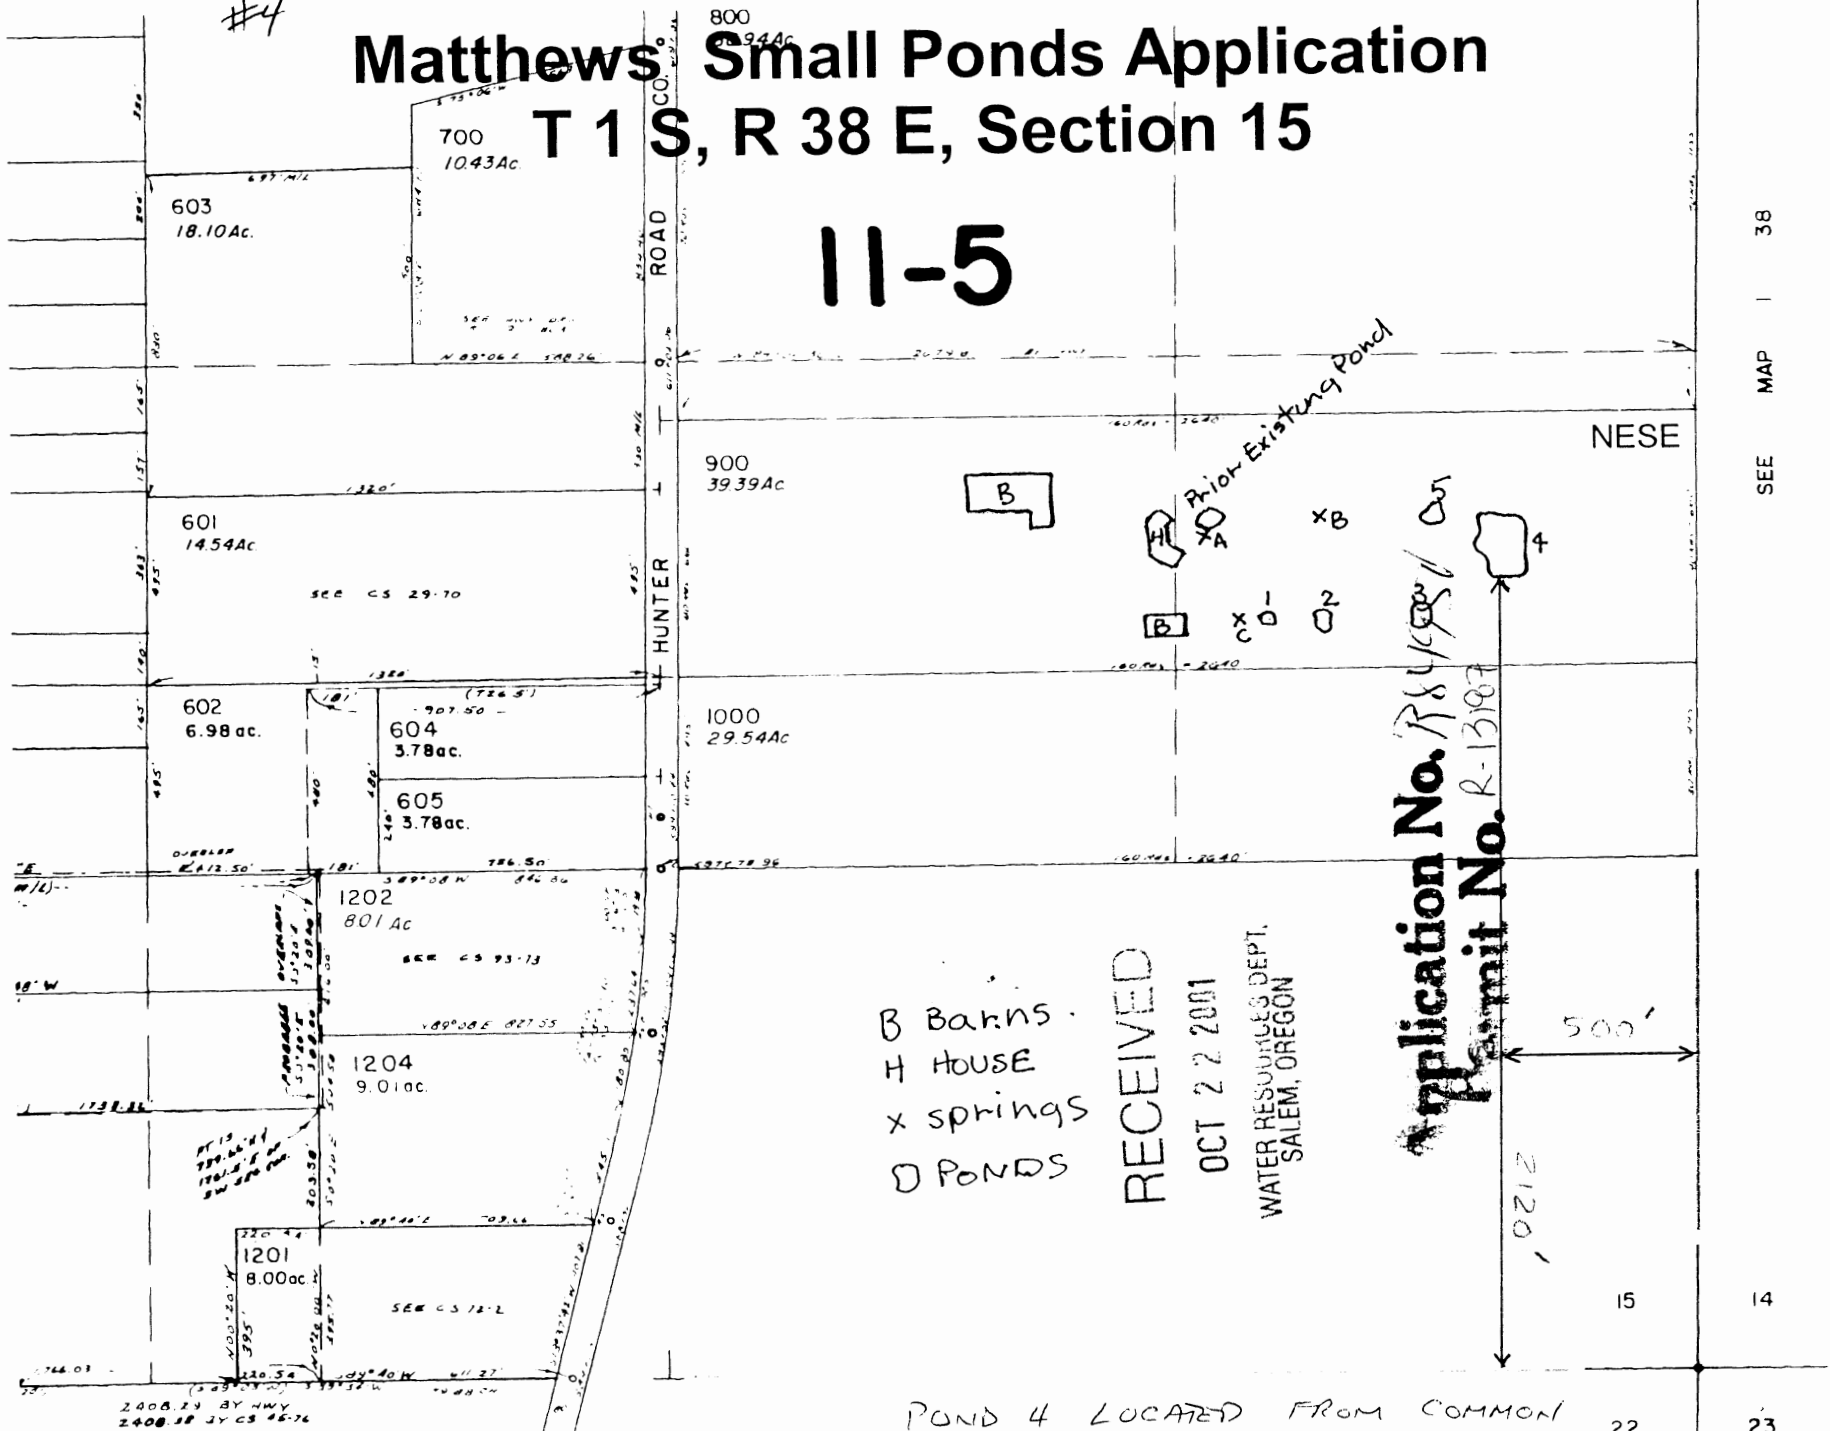

Scale 1" = 500'

SEE MAP | 38

