


#5

Matthews Small Ponds Application

T 1 S, R 38 E, Section 15

11-5

Application No. R 84457
Permit No. R-13108

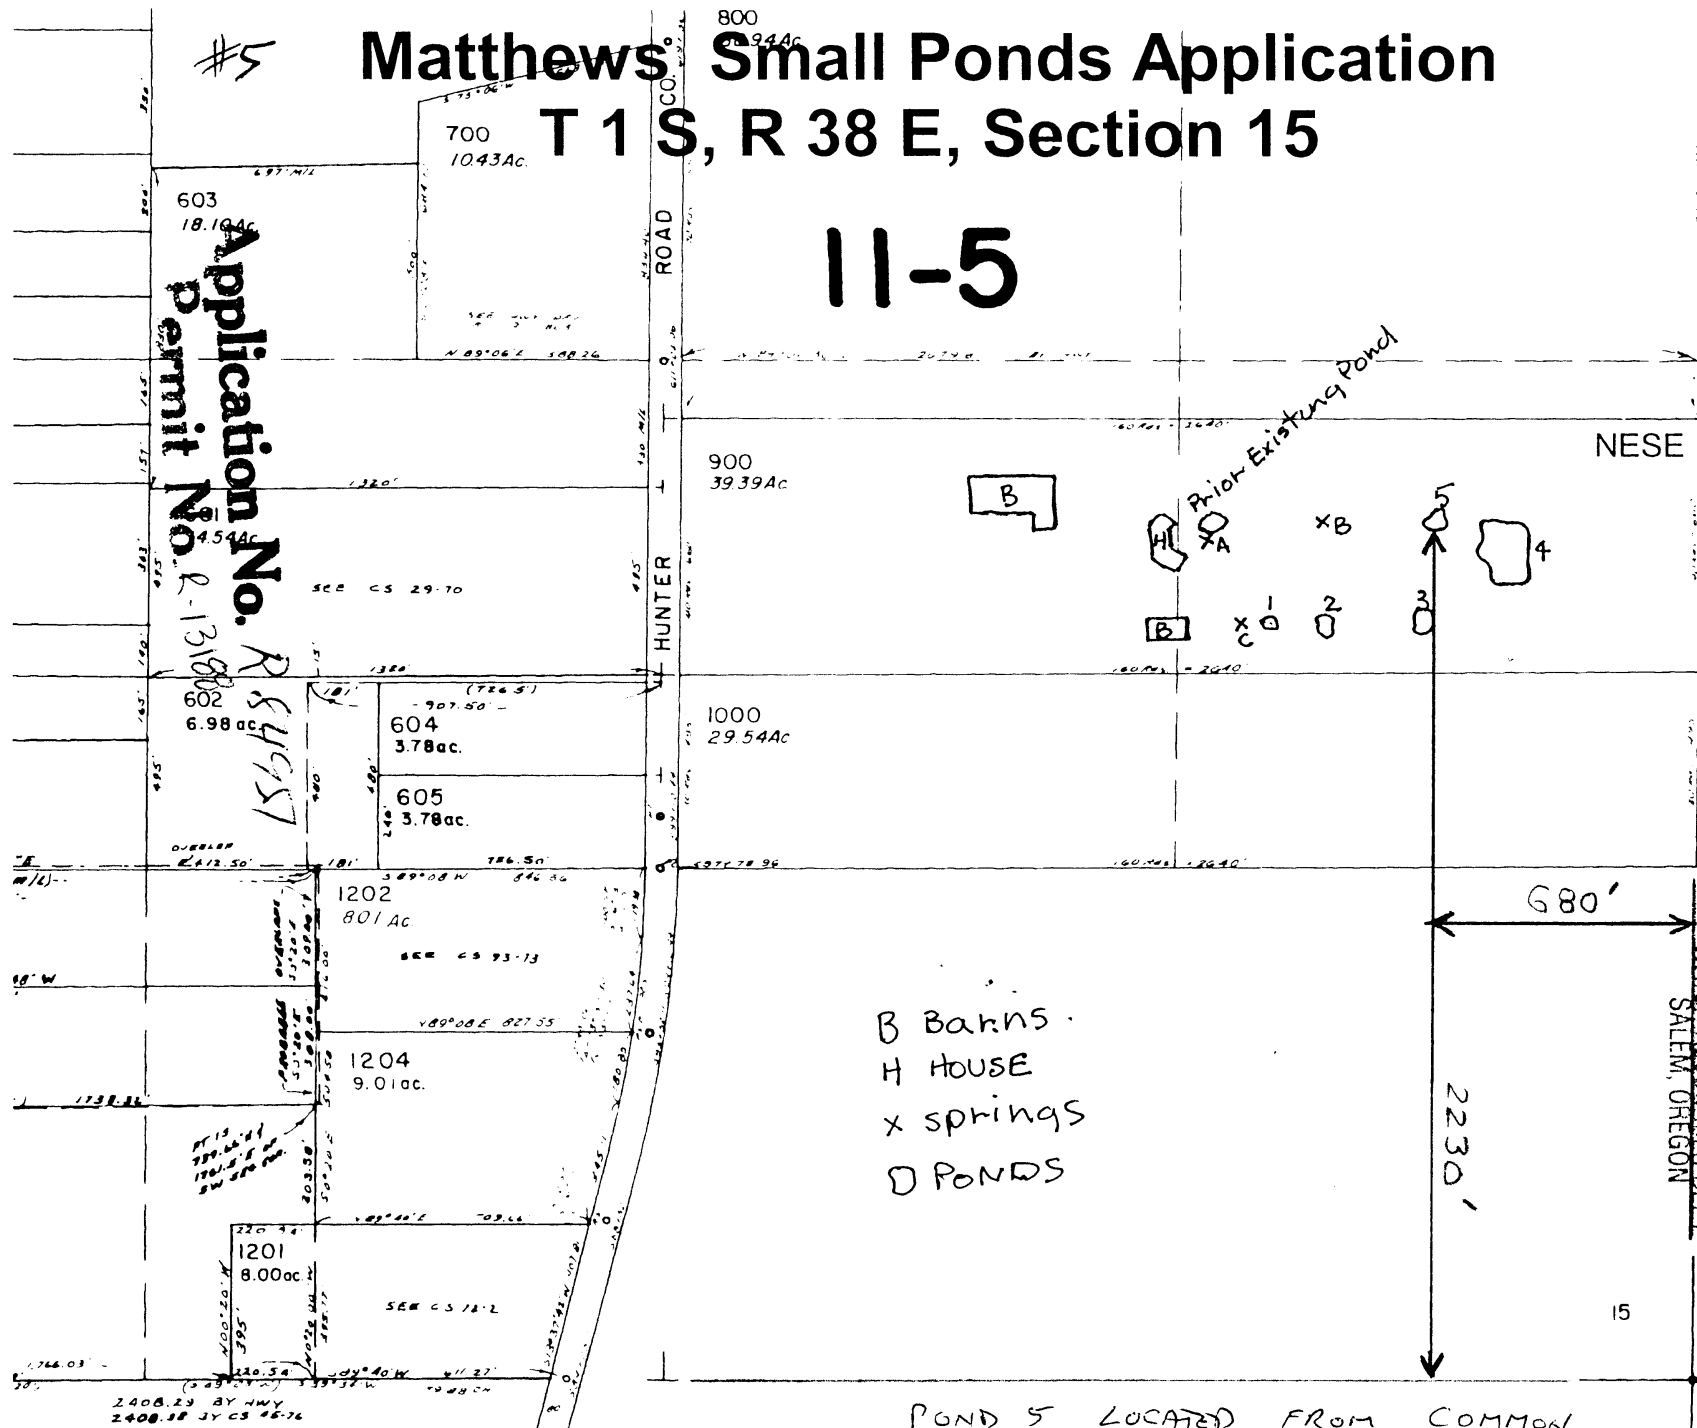

Scale 1" = 500'

POND 5 LOCATED FROM COMMON
SECTION CORNER 14, 15, 22, 23
680' WEST & 2230' NORTH

38
MAP
SEE

RECEIVED
OCT 22 2001
WATER RESOURCES DEPT
SALEM, OREGON

