

THIS MAP WAS PREPARED FOR
ASSESSMENT PURPOSE ONLY

SEC. 10 T.29S. R.7 W W.M.
DOUGLAS COUNTY

REVISED ON
6-4-97


1"=400'

Application No. 2-94833
Permit No.

SEE MAP 29 7 3

Pond #1
100' South + 400' East
from the NW corner of
section 10

Pond #2

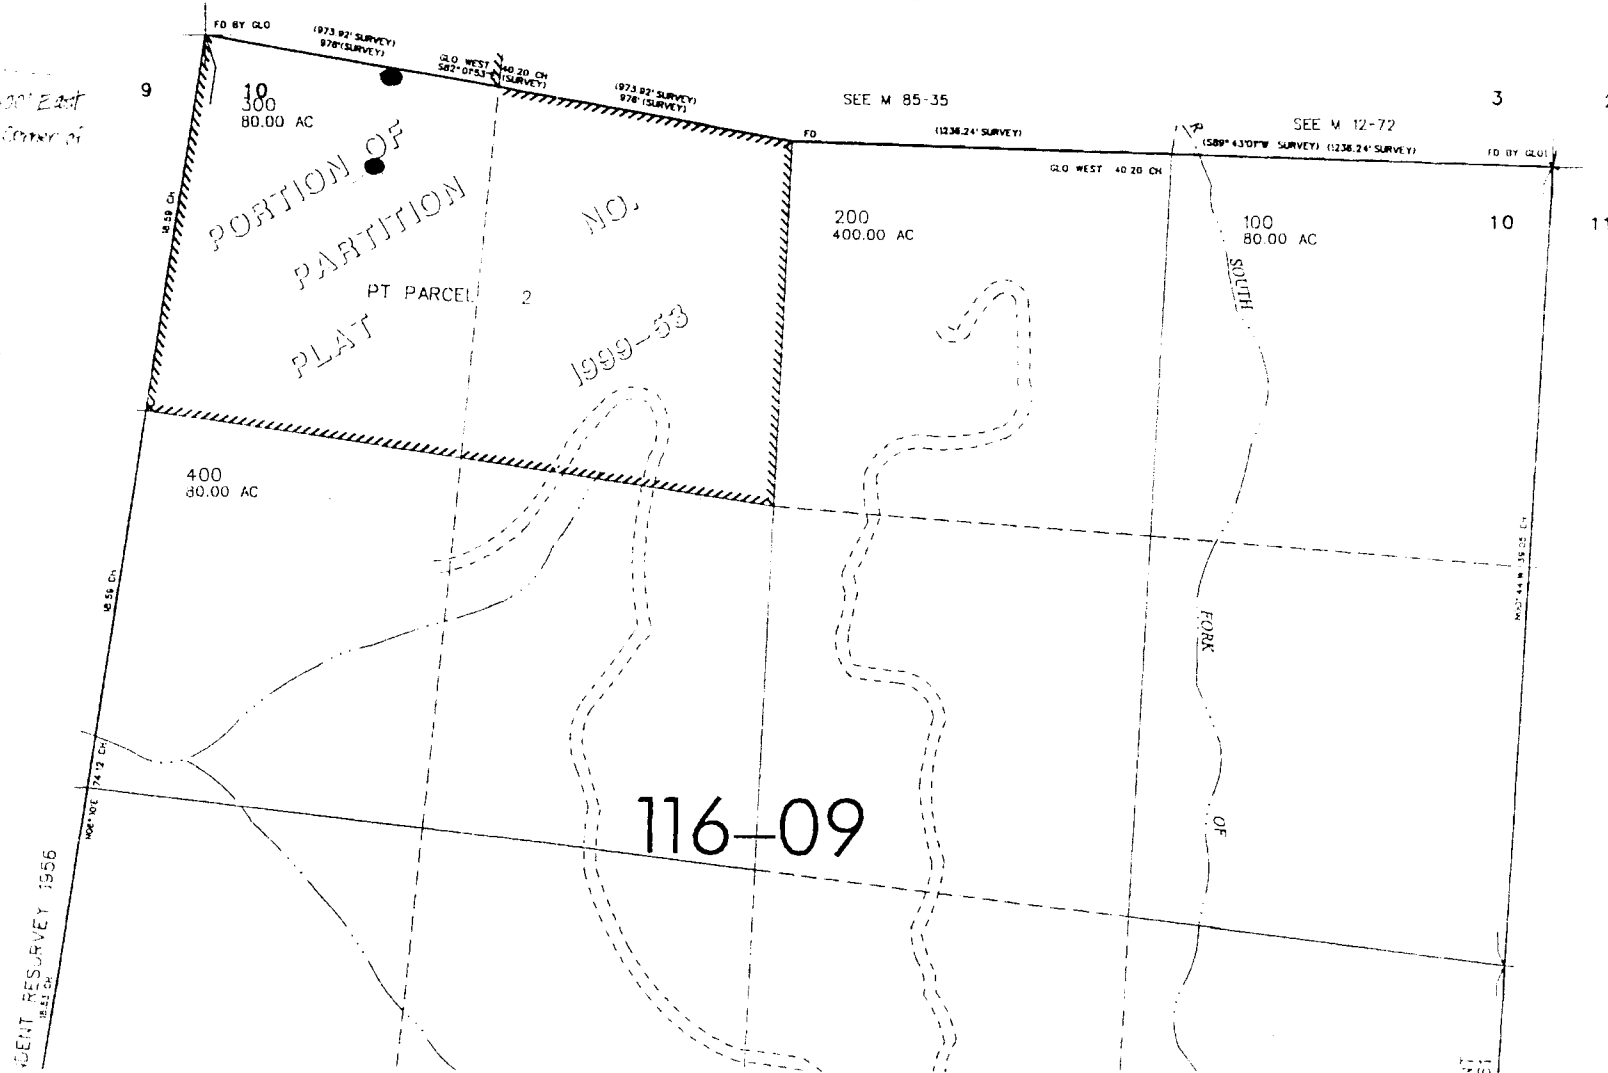

RECEIVED
AUG 14 2007
WATER RESOURCES DEPT
SALEM, OREGON

6 4 67 87M 333

RECEIVED BY OWRD

JUN 19 2015

SALEM, OR