


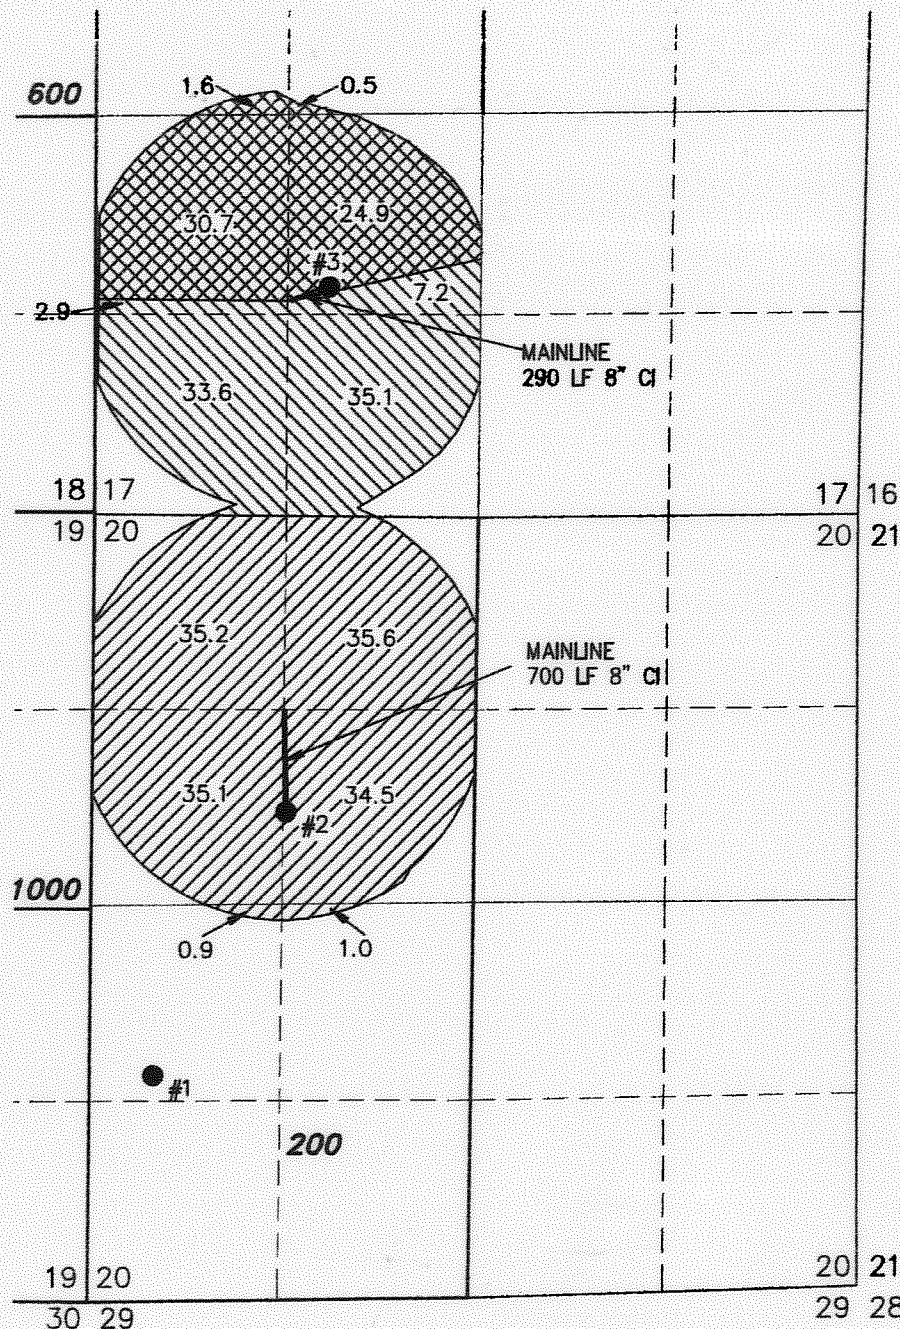

SCALE: 4 INCHES = 1 MILE



FINAL PROOF MAP

TO SHOW PLACES OF USE AND
POINTS OF APPROPRIATION
FOR APPLICATION T-11345
PEILA RANCH, INC.

SECTIONS 17 & 20, TOWNSHIP 27 SOUTH, RANGE 23 EAST, W.M.
TAX LOT: 200, LAKE COUNTY, OREGON

- **#1 (LAKE 52281) PERMIT: G-2232**
LOCATED IN THE NW 1/4 OF THE SW 1/4 & 1500' NORTH
& 440' EAST FROM THE SW CORNER OF SECTION 20. NOT
CONNECTED TO IRRIGATION SYSTEM.
- **#2 (LAKE 52282) PERMIT: G-2232**
LOCATED IN THE SE 1/4 OF THE NW 1/4 & 3290' NORTH
& 1350' EAST FROM THE SW CORNER OF SECTION 20.
FLOW METER IS $\pm 3.5'$ S FROM CENTER PIVOT ON MAIN PIPE.
- **#3 (LAKE 52283) PERMIT: G-6124**
LOCATED IN THE NE 1/4 OF THE SW 1/4 & 1560' NORTH
& 1615' EAST FROM THE SW CORNER OF SECTION 17.
FLOW METER IS $\pm 3.5'$ E FROM CENTER PIVOT ON MAIN PIPE.


BURIED 8 INCH STEEL PIPE

-  142.3 ACRES PRIMARY IRRIGATION FROM
#2 (G-2232), AS SHOWN
-  57.7 ACRES PRIMARY IRRIGATION FROM
#3 (G-2232), AS SHOWN
-  78.8 ACRES PRIMARY IRRIGATION FROM
#3 (G-6124), AS SHOWN

RECEIVED BY OWRD

APR 11 2014

SALEM, OR

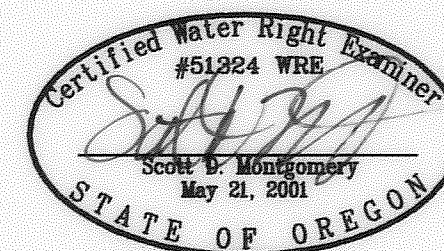

RENEWAL DATE: 12/31/2014

THIS MAP IS FOR THE PURPOSE OF LOCATING A WATER
RIGHT ONLY AND HAS NO INTENT TO PROVIDE LEGAL
DIMENSIONS OR THE LOCATION OF PROPERTY LINES

PREPARED FOR:
PEILA RANCH, INC.
P.O. BOX 697
BURNS, OR 97720

PREPARED BY:



ALL POINTS ENGINEERING AND SURVEYING, INC.
P.O. BOX 767 (CRR) TERREBONNE, OR 97760
(541) 548-5833
www.APEandS.com