


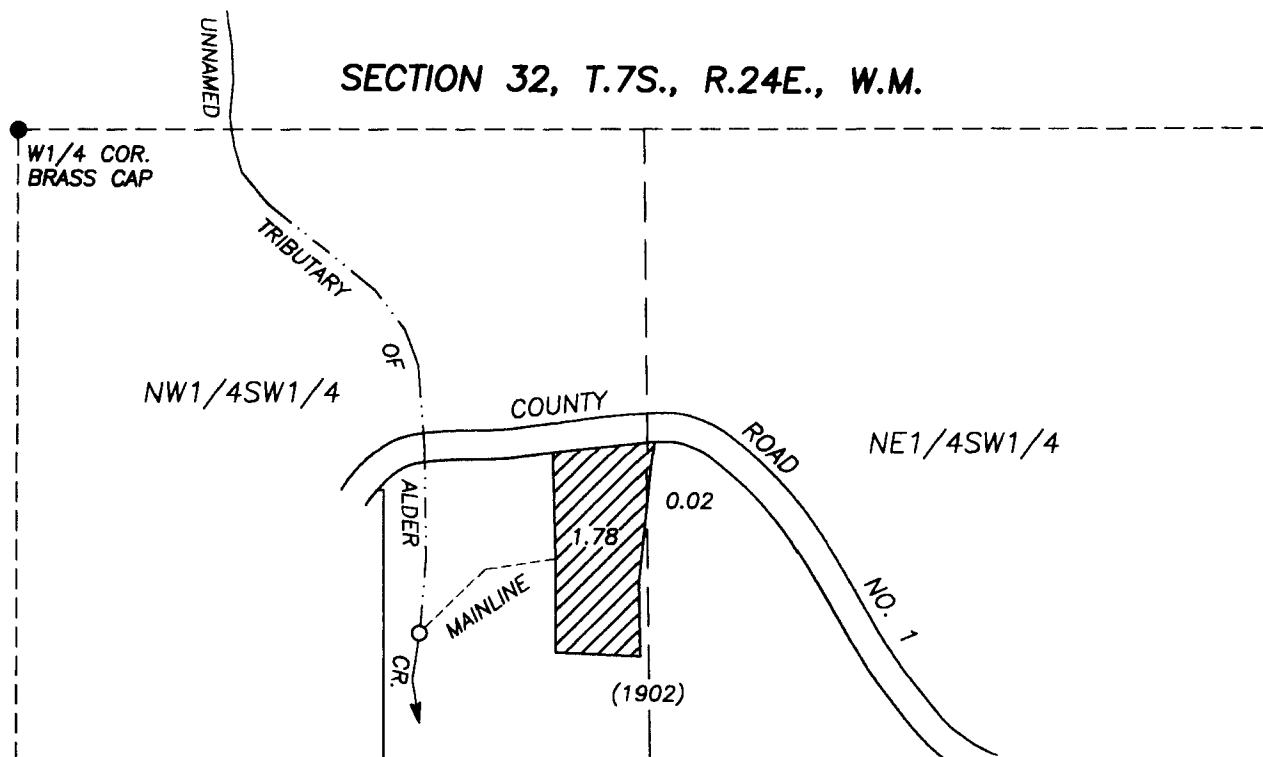

POD IS 1,040' SOUTH & 830' EAST OF W1/4 COR. SEC. 32

FINAL PROOF SURVEY

UNDER
APPLICATION NO. T-8501
PERMIT NO. SPECIAL ORDER
VOL. 55, PAGE 1256

IN NAME OF
CLEO S. SLIFER AND RANDAL R. SLIFER



SCALE 1"=400'

RECEIVED BY OWRD


JAN 10 2014

SALEM, OR

- POD - PUMP AND FISH SCREEN
- MAINLINE
- (1902) TAX LOT NO.
-  PLACE OF USE

NOTE: THE PREPARATION OF THIS MAP WAS FOR THE PURPOSE OF IDENTIFYING THE LOCATION OF THE PROPOSED WATER RIGHT AND HAS NO INTENT TO PROVIDE DIMENSIONS OR LOCATION OF PROPERTY OWNERSHIP LINES.

PREPARED BY
ROBERT D. BAGETT
217 N. CANYON BLVD.
JOHN DAY, OR. 97845
September 27, 2013

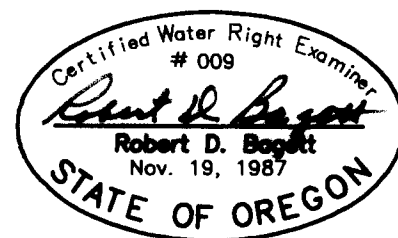

RENEWS 12-31-13