


T.26 S., R.31 E., W.M.
 South of Malheur Lake

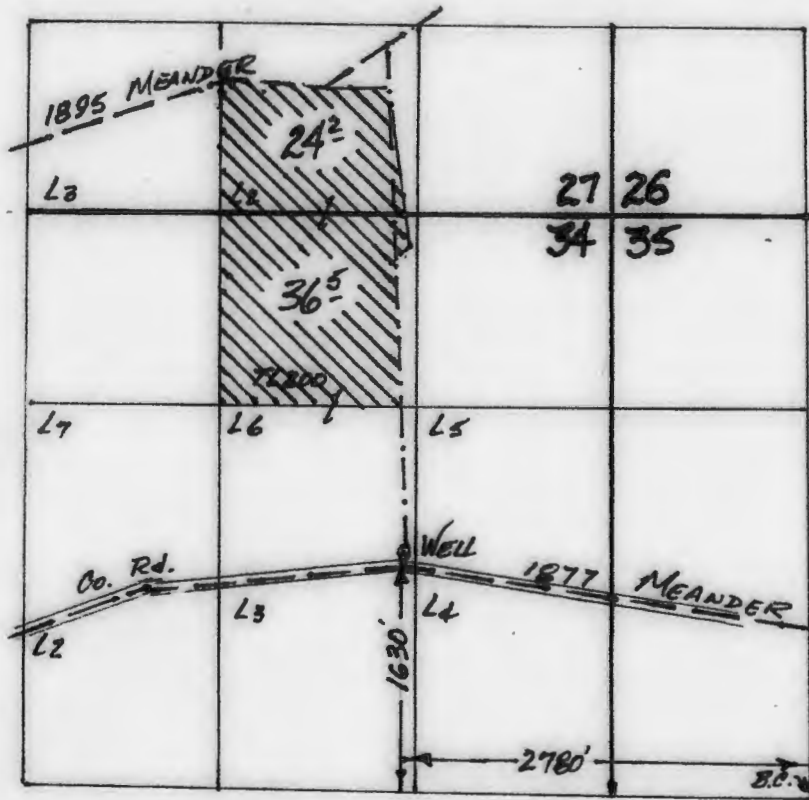

Scale: 4" = 1 mile



CLAIM of BENEFICIAL USE MAP
 For
Jett Blackburn, Sod House Farm

Under T-10109

RECEIVED
 DEC 31 2012



This map is for the purpose of identifying the location of water rights only, and is not intended to provide legal dimensions or locations of property lines.

10/2012 *[Signature]*