


T.7S, R.19E.W.M.

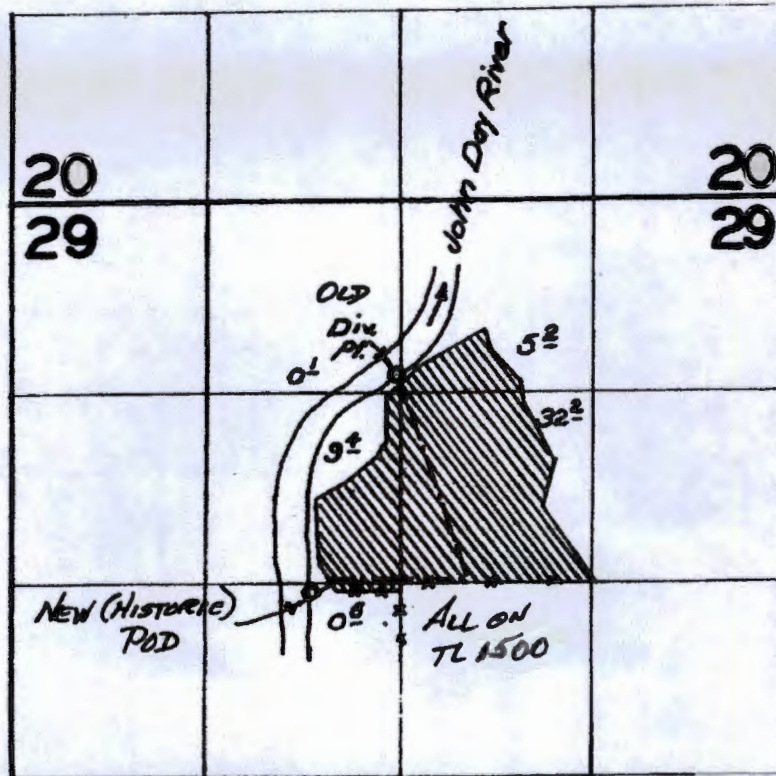

Map to Accompany Application
for Historical Change in Point of Diversion Under Certificate
31407 In the Name of
Mary Maurer Revocable Living Trust

RECEIVED
SEP 14 2015
OWRD

Scale ; 1" = 1,320'

POD's Located: Old POD- 1,440' N. & 80' W.; New (Historic) POD- 60' S. & 620'
W.; both from the Center 1/4 Corner, Section 29.

This map is for the purpose of identifying the location of water rights only, and is not
intended to provide legal dimensions or locations of property lines.


T 12163

Aug. 2015 *[Signature]*



Google earth

miles
km

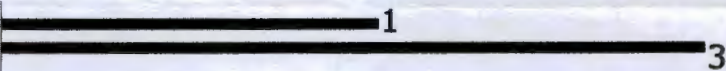

Imagery date 7/4/2012

44° 56' 18.61" N. 120° 29' 30.54" W.

elev. 1438 ft.

T 12163

RECEIVED
SEP 14 2015
OWRD