

FINAL PROOF SURVEY IN THE NAME OF MILLER FORESTS, INC.
T 8 S R 4 W, W.M.

REVISED
Oct. 2, 2016

File: T-7126
COBU


scale 4" = 1 mile

WILLAMETTE RVR.
#1: 650' S & 550' E from the SE cor. DLC 56
#2: 440' S & 50' W
#3: 2075' S & 650' W
both from the N ¼ cor. Sec. 14

HUMBUG LAKE
#1: 520' N & 50' E
#2: 30' N & 400' W
#3: 1460' S & 470' W
all from the NW cor. Sec. 14

WELLS
#1: 30' N & 1370' W
#2: 2620' S & 1770' W
#3: 2600' S & 370' W
all from the NE cor. DLC 41

DCL line ———
Section line ———
¼ ¼ line ———
Div. Pt. ○

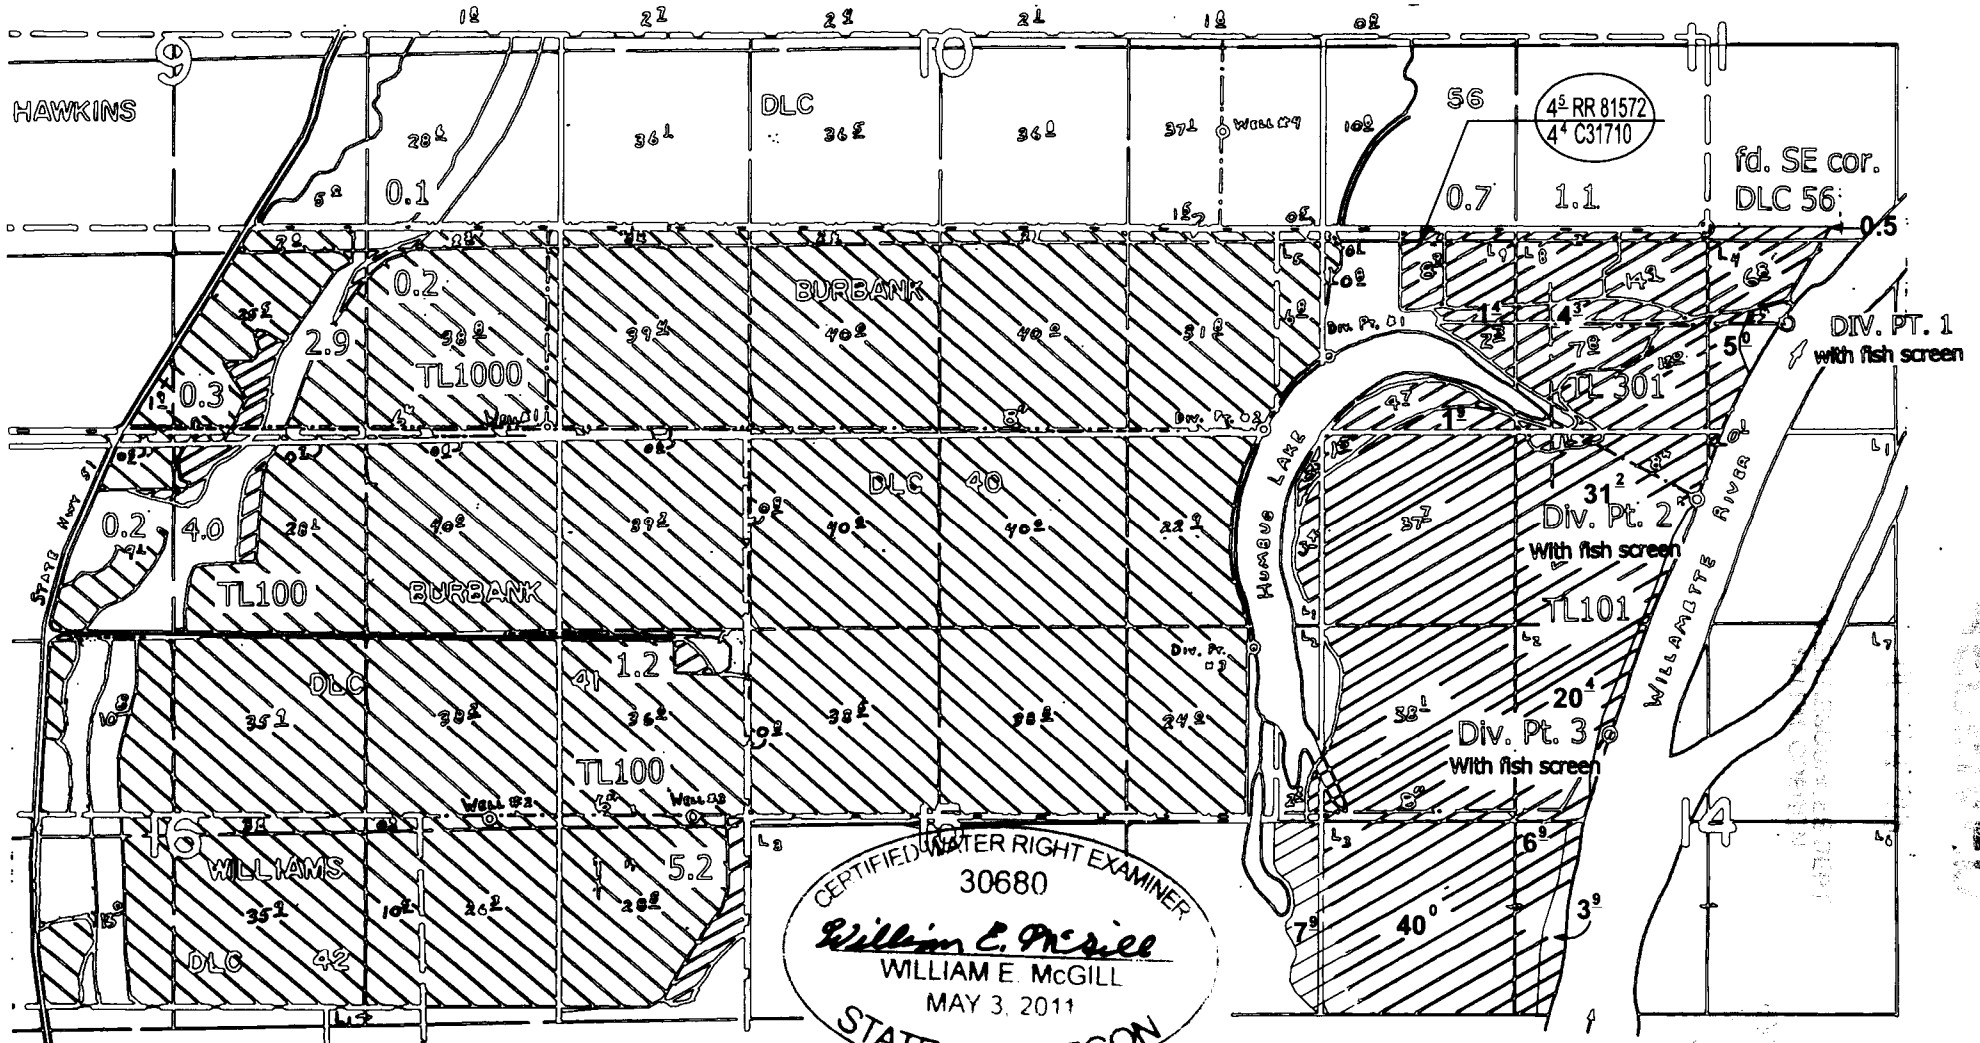

This map is for water right purposes only.

EXPIRES 12/31/2016