


T-8897

TOWNSHIP 14 SOUTH, RANGE 14 EAST, W.M.

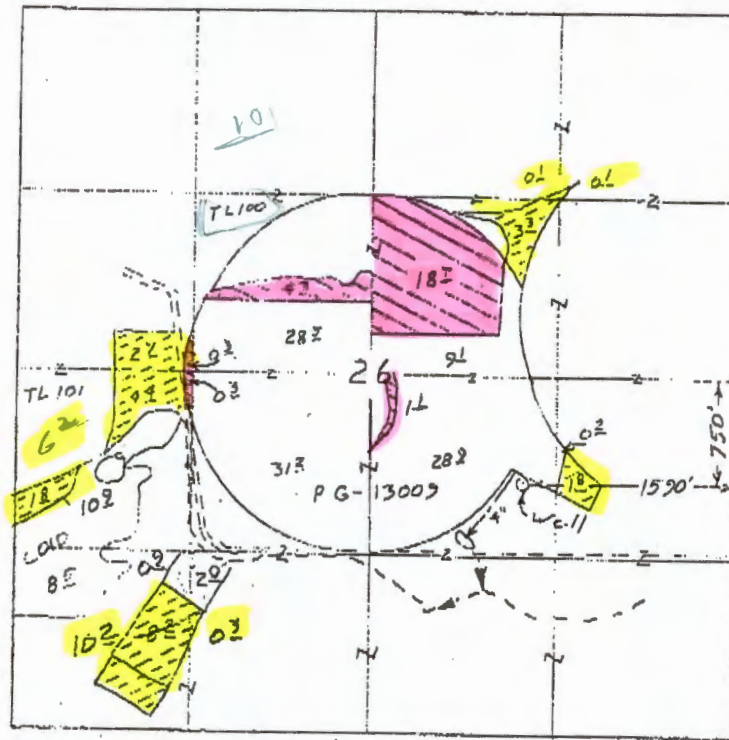

C-87116

- ☺ From 247 acres (~~Permit G-13009 Claim of Beneficial Use~~)
 ☺ To 247 acres

Transfer Application Map
 for
 LARK RANCH


RECEIVED

SEP 28 2001

WATER RESOURCES DEPT.
SALEM, OREGON

T-8897

COPY

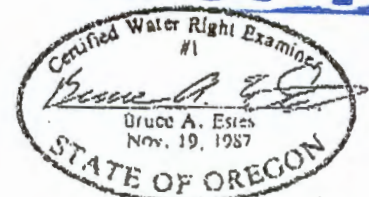

Renewal Dec 31, 2001

This map is for the purpose of
 locating a water right only
 and has no intent to provide
 legal dimensions or the location
 of property lines.


ESTES SURVEYS

PO Box 17519
 Salem, OR 97305-7519
 (503) 585-7593

60382 Arnold Rd
 Bend, OR 97702
 (541) 382-7391

T-8897

TOWNSHIP 14 SOUTH, RANGE 14 EAST, W. M.

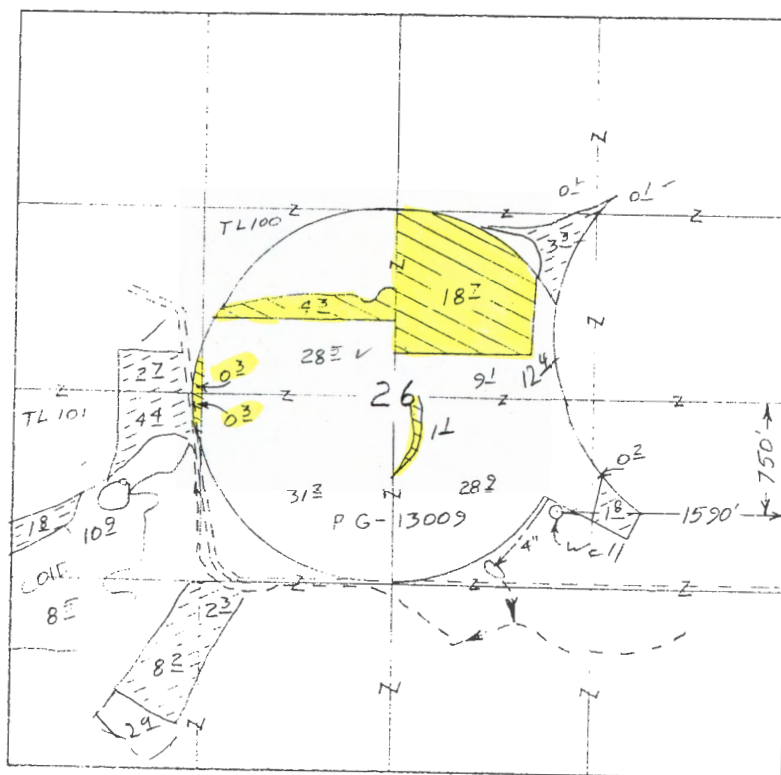


- ⊖ From 247 acres (Permit G-13009 Claim of Beneficial Use)
- ⊙ To 247 acres

Transfer Application Map for LARK RANCH

RECEIVED

SEP 28 2001

WATER RESOURCES DEPT.
SALEM, OREGON

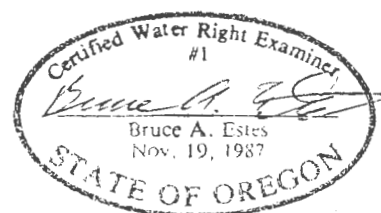

Renewal Dec 31, 2001

This map is for the purpose of
locating a water right only
and has no intent to provide
legal dimensions or the location
of property lines.

ESTES SURVEYS

PO Box 17519 60382 Arnold Rd
Salem, OR 97305-7519 Bend, OR 97702
(503) 585-7593 (541) 382-7391