



Township 3 South, Range 2 East, W.M.
Portions of Sections 26, 27, 34 & 35

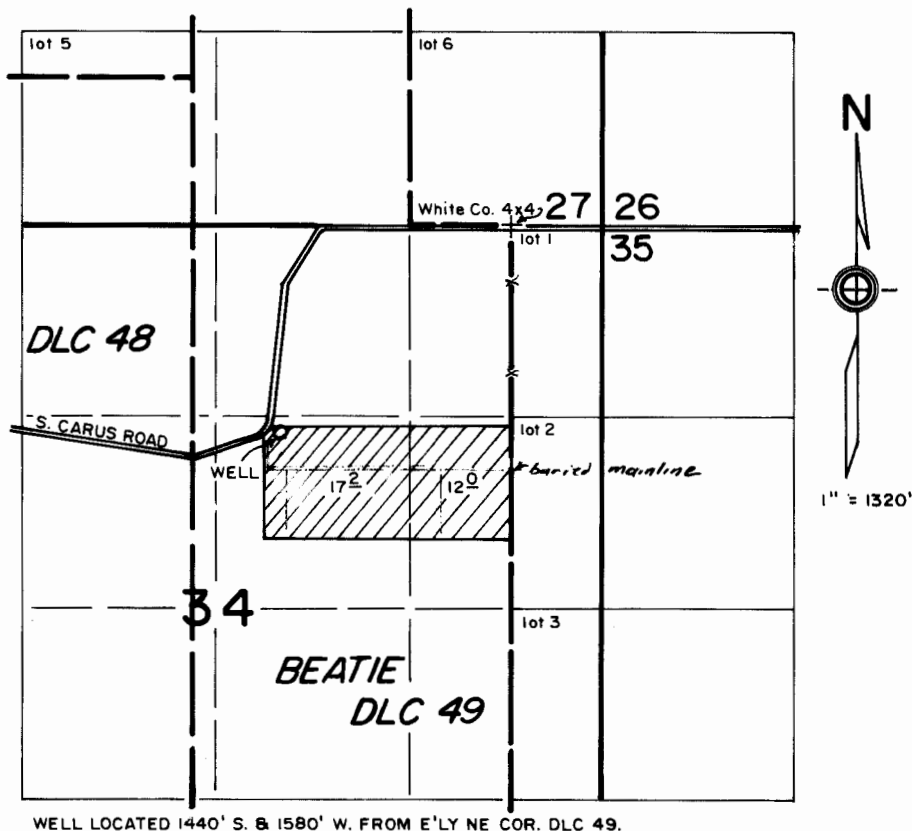

FINAL PROOF SURVEY
under
Appl. No. G-13406, Per. No. G-11752
in name of
MEADOWCROFT FARM
Jan. 3, 1996

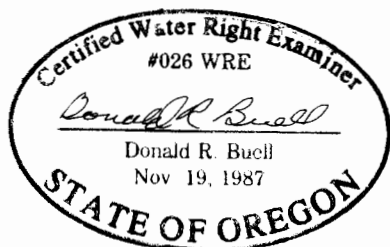

THIS MAP WAS PREPARED FOR THE PURPOSE OF
IDENTIFYING THE LOCATION OF A WATER RIGHT
ONLY AND IS NOT INTENDED TO PROVIDE LEGAL
DIMENSIONS OR LOCATION OF PROPERTY
OWNERSHIP LINES.