


T. 3 S., R. 3 E., W.M.

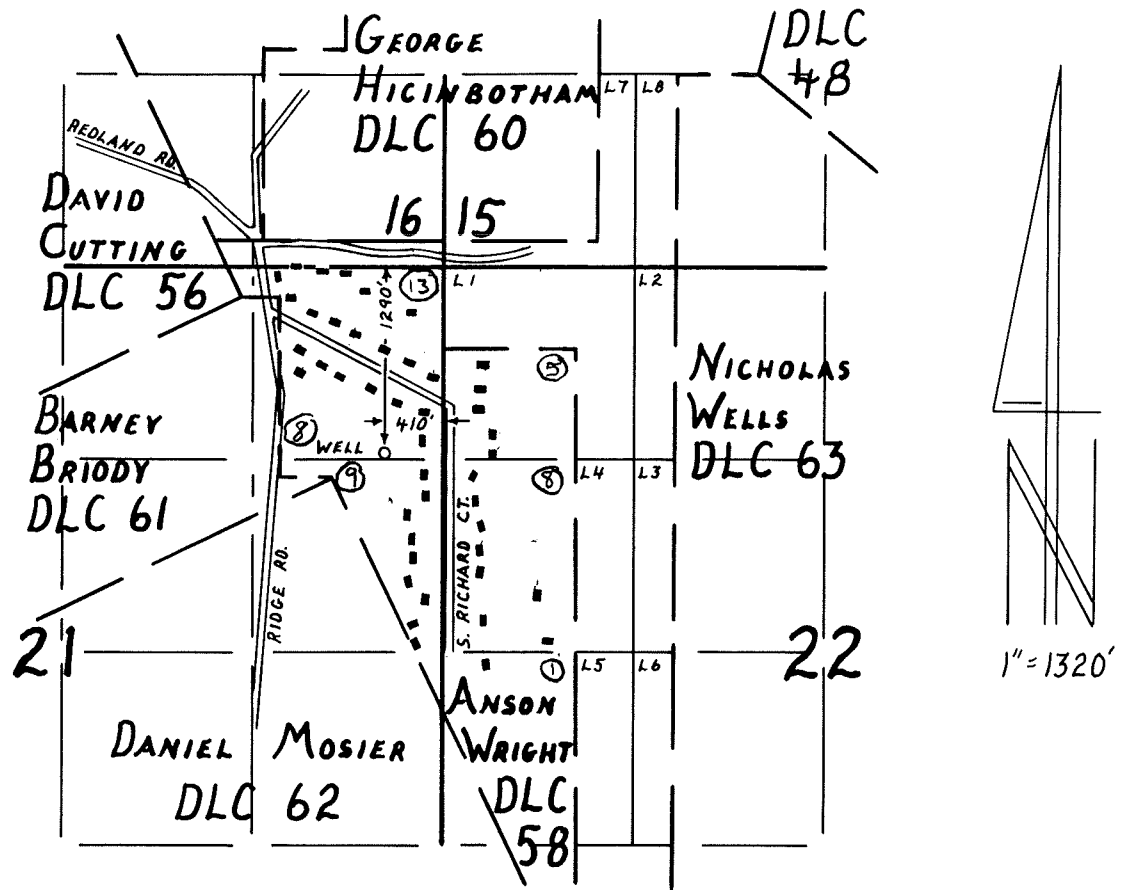

FINAL PROOF SURVEY

UNDER

Application No. G-11515 Permit No. G-10673
IN NAME OF

POLEHN HEIGHTS WATER ASSOCIATION, INC.

Surveyed AUGUST 21, 1992, by R.W. Klassen