

OFFICE OF STATE ENGINEER

RECEIVED

OCT 2 1911

SALT . ORK

Application No. 1750
Permit No. 882


I G.M. Klein for E.B. Henry County Surveyor of Klamath Falls,

Klamath County do hereby certify that this map was made from notes taken during an actual survey made by me on Sept 18, 1911, and

that it correctly represents the works described in the accompanying application, together with the location of Streams and other ditches

in the immediate vicinity, and has written thereon the acres in each smallest legal subdivision which it is proposed to irrigate

E.B. Henry County Surveyor
George M. Klein
Deputy.

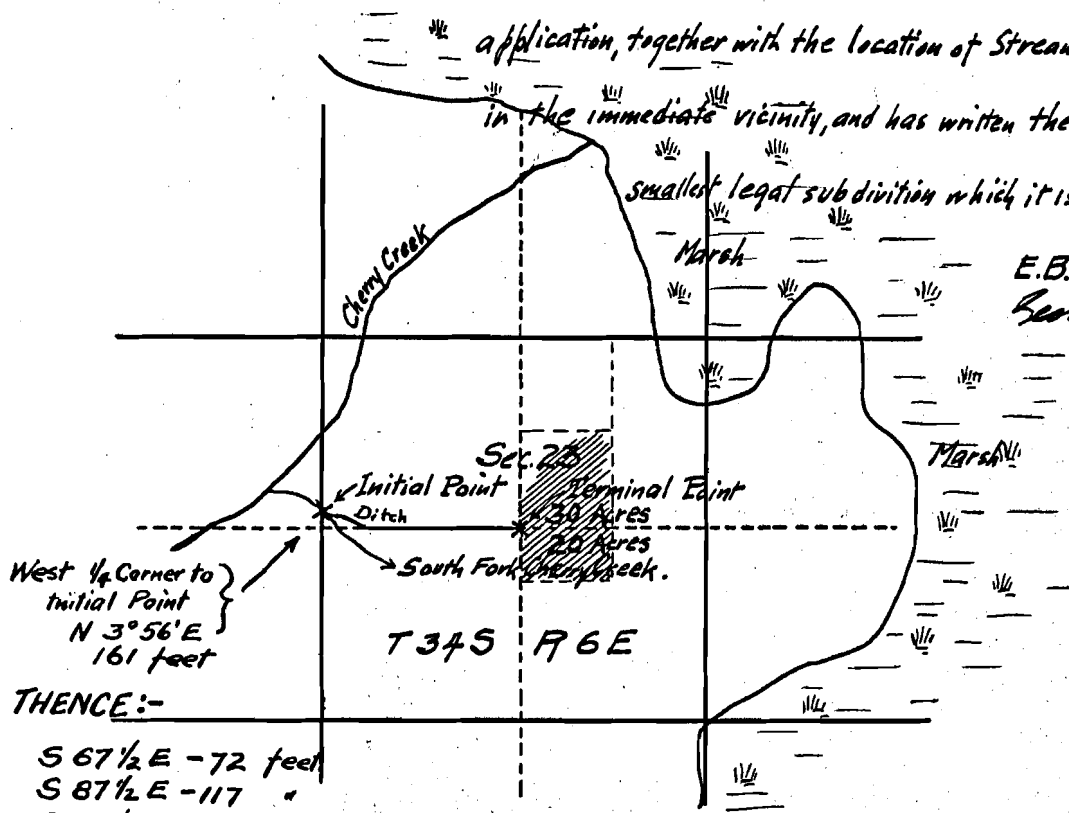

THENCE:-

S 67 1/2° E - 72 feet

S 87 1/2° E - 117 "

S 70 1/2° E - 382 "

S 89° 55' E - 2100 feet to Terminal Point which is also Center Corner of Sec 23

MORRISON

DITCH

Scale 2" = 1 mile.

In Sec. 23 - T 34 S, R 6 E.

Cherry Creek & mor.