


T. 3 N. R. 29 & 30 E. W.M.

G-2415
37252

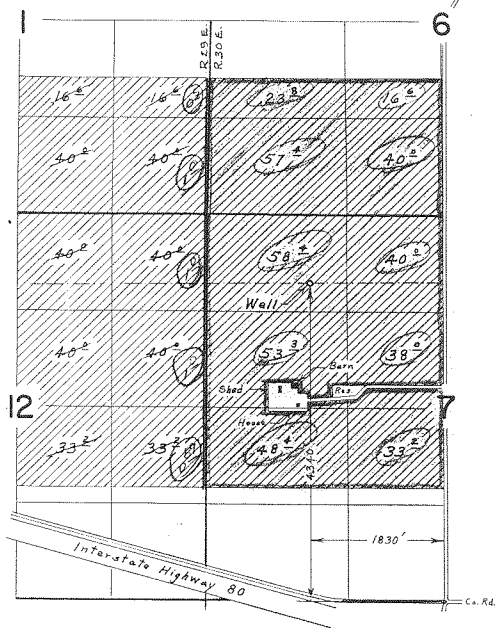

FINAL PROOF SURVEY
UNDER

☐ All this
LAND Included
ON CERT.
37252

Application No. G-2588. Permit No. G-2415.
IN NAME OF

MARSHALL E. MEYERS

Surveyed July 11, 1969, by L. E. Gould.