


WATER RIGHT TRANSFER MAP FROM C# 66862

T 38 S, R 8 W, W M, JOSEPHINE COUNTY

Section 22, SE1/4 NW1/4

March 25, 2016

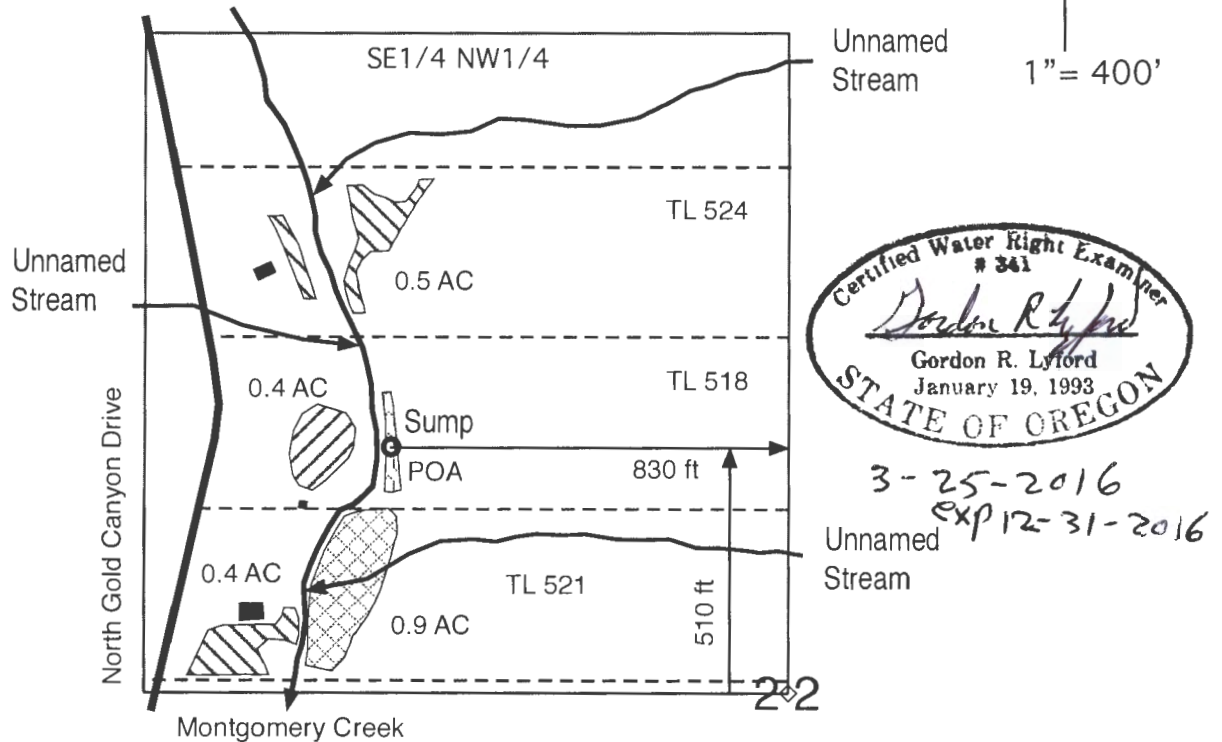

Note: the location of the sump described in certificate 66862 is incorrect.

Certificate 66862 provides for the irrigation of 1.3 acres from one sump under application G-6696 and permit G-6242 with a priority of October 18, 1974 at a rate of 0.0125 cfs/acre and a duty of 2.5 AF/AC.

- Point of appropriation (POA) from the sump.
- ▨ 0.9 acres of existing irrigation rights to be transferred to new places of use.
- ▧ 0.9 acres of proposed irrigation rights new places of use.
- ▩ 0.4 acres of remaining irrigation rights place of use.
- Tax lot lines.
- Houses.

This map was drawn by Gordon R. Lyford for Dawn R. Present to support her water right transfer application to change the places of use for irrigation from a sump. Dawn R. Present owns tax lots 518, 521, and 524.

This map was prepared for the purpose of identifying the location of water rights only and is not intended to provide legal dimensions or the location of property ownership lines.


RECEIVED BY OW

MAR 30 2016

SALEM, OR

T 12325

T. 38 S., R. 8 W., W. M.

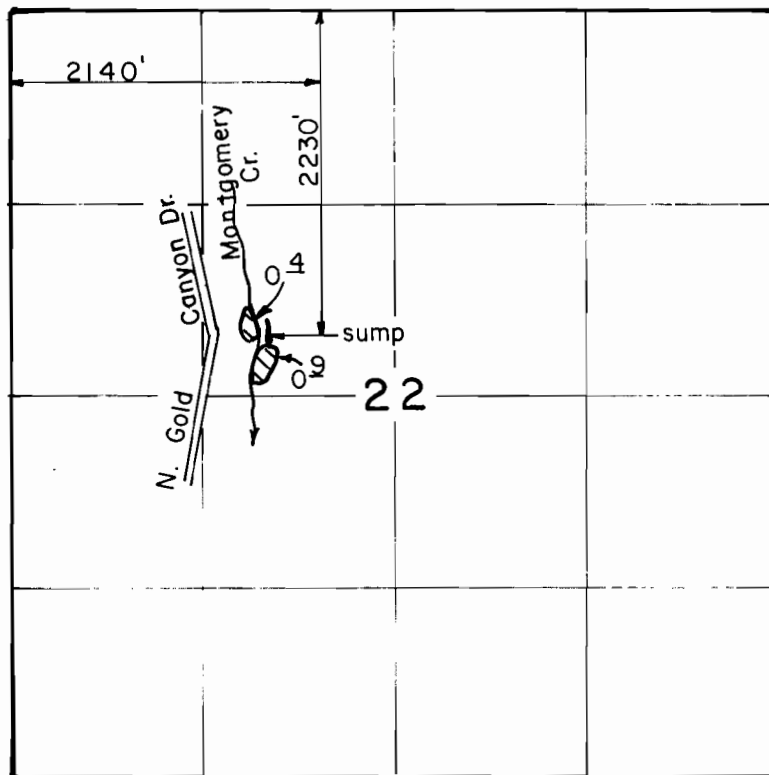

Scale: 1" = 1320'

**FINAL PROOF SURVEY
UNDER**

**Application No. G-6696 Permit No. G-6242...
IN NAME OF**

DAWN RAINRABBIT & SUMA SHAAZ MUNDA

Surveyed APR. 18. 1988., by B.S. JAMES...