

2024.155
(CPNER)

UNITED STATES
DEPARTMENT OF THE INTERIOR
GEOLOGICAL SURVEY

R-8203

45

27E


Application No. R82571

Permit No. W 112131

RECEIVED

MAR - 7 1997

WATER RESOURCES DEPT.
SALEM, OREGON

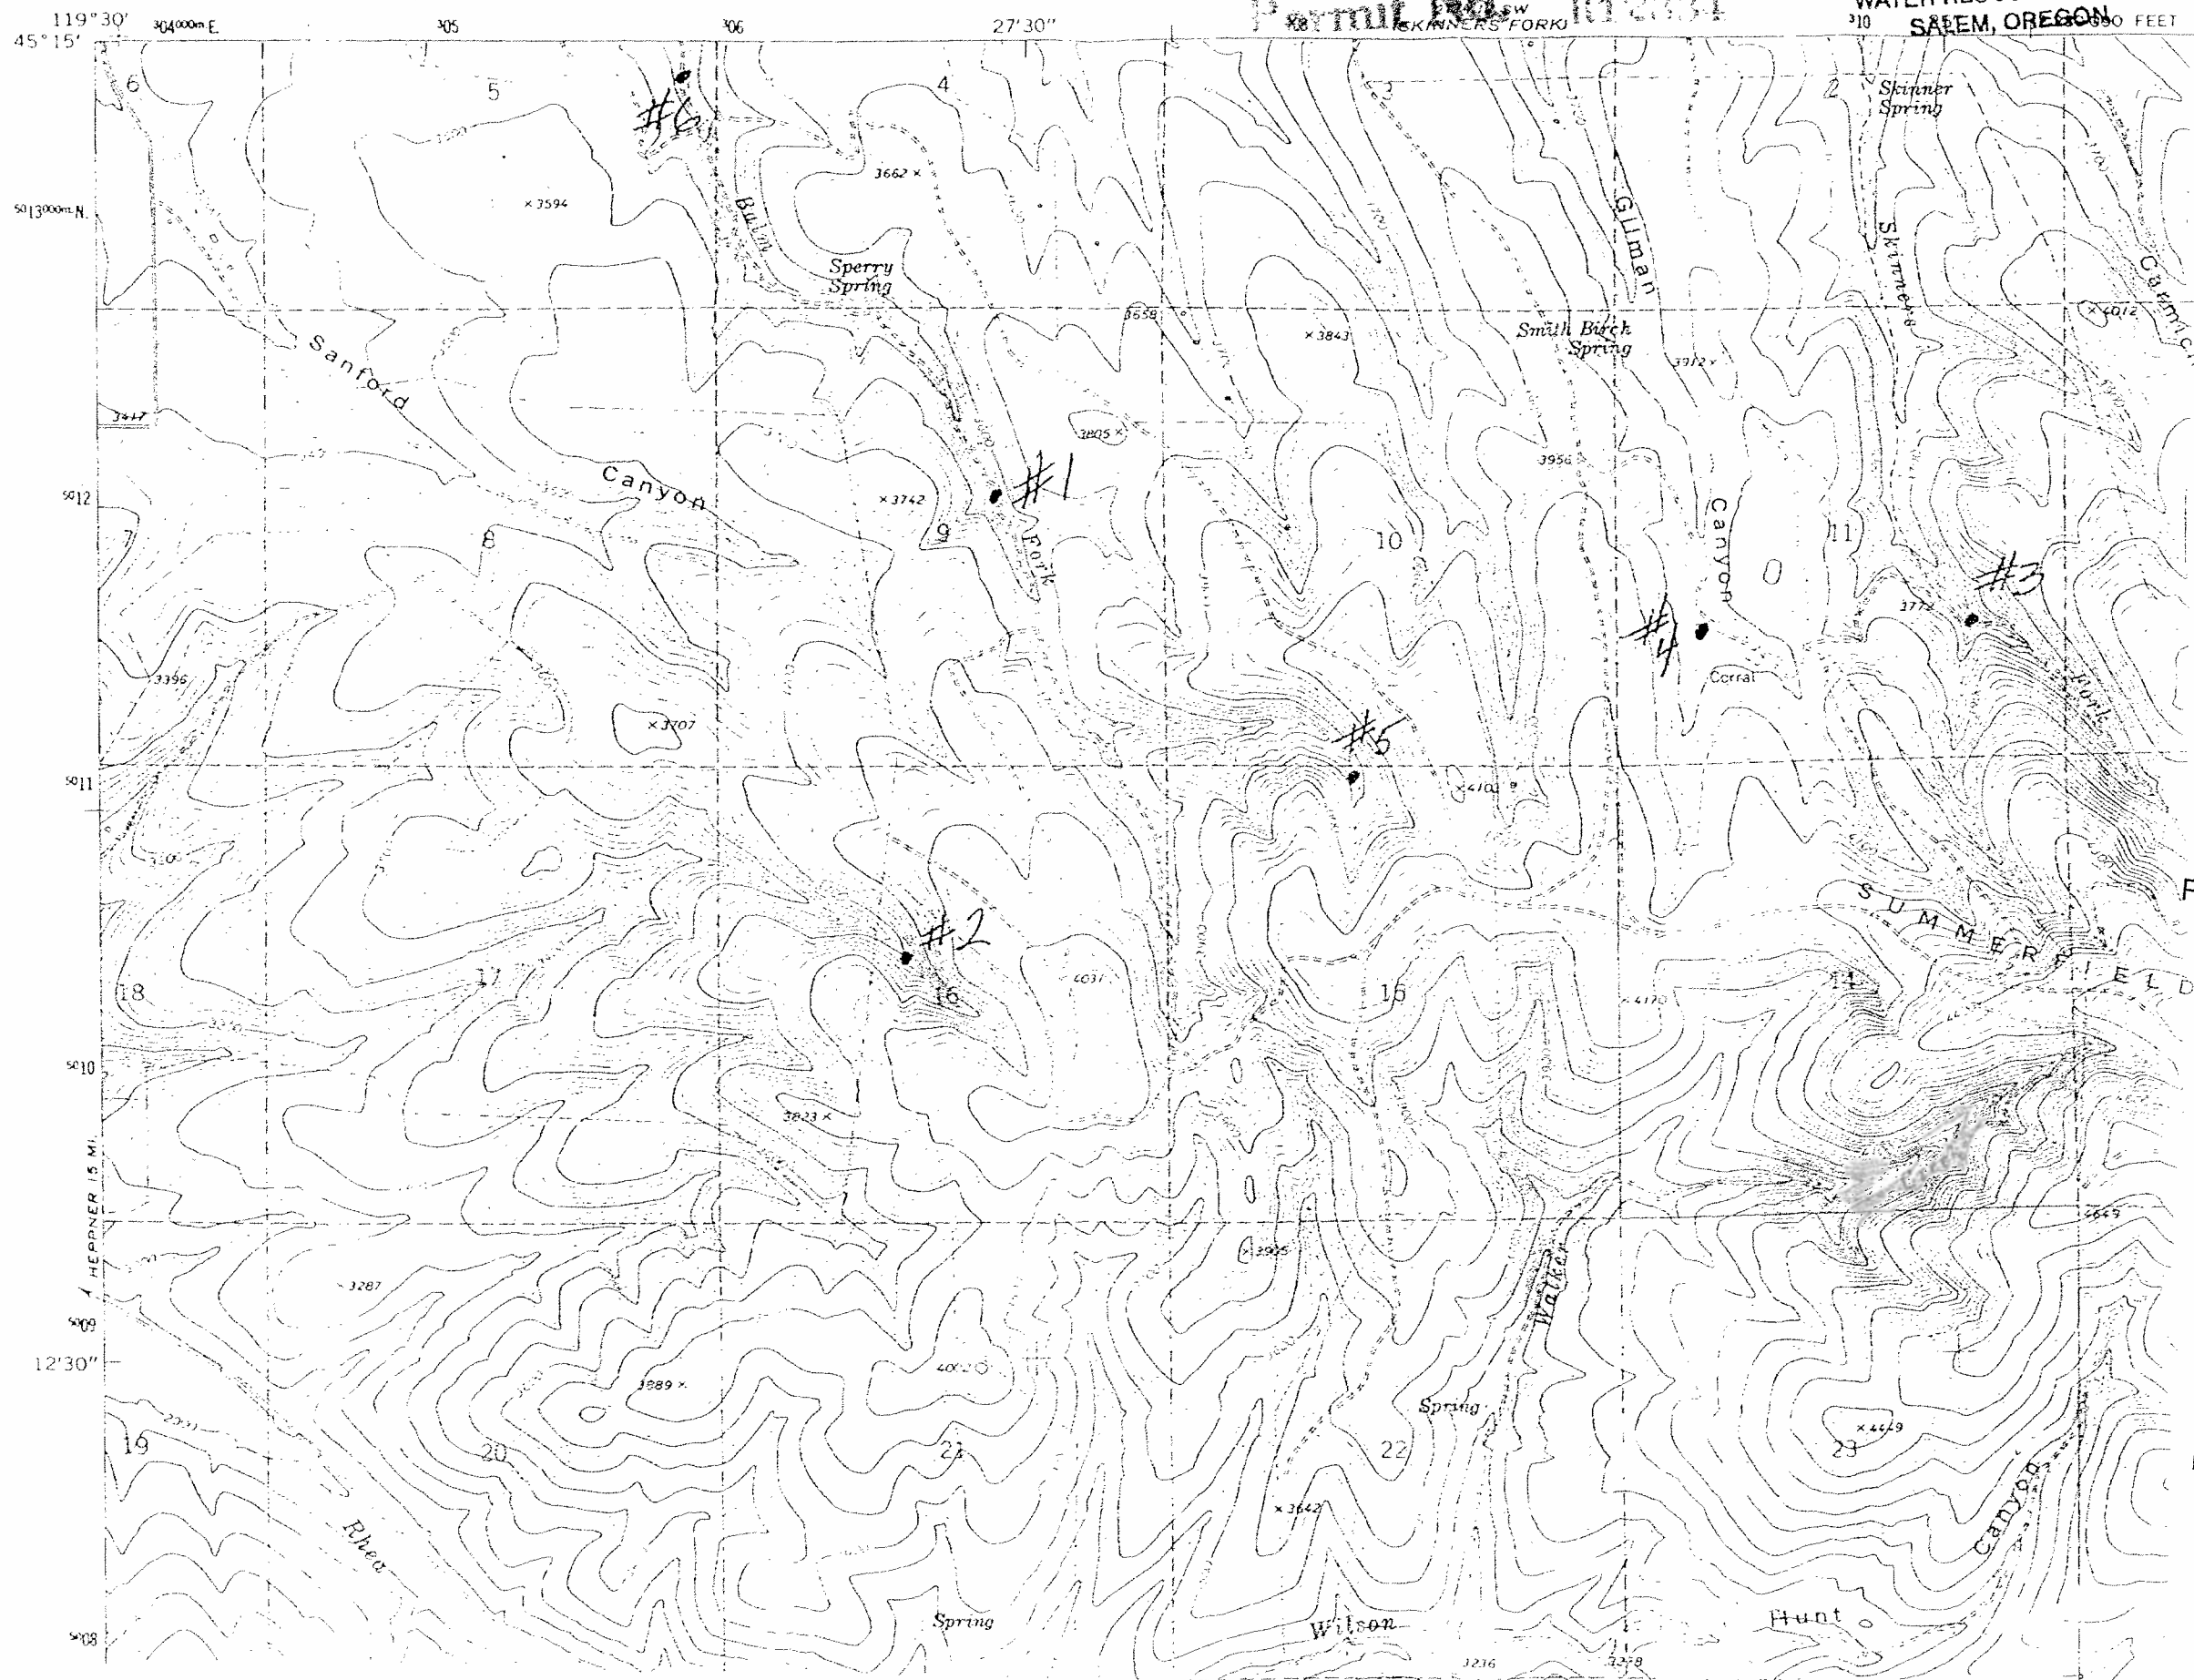

RECEIVED BY OWRD

OCT 05 2015

SALEM, OR

N

1 inch = 2,030 ft