

2024 SE
COPPER

UNITED STATES
DEPARTMENT OF THE INTERIOR
GEOLOGICAL SURVEY

R8203

45


27E

Application No. R83571
Permit No. R12734

RECEIVED

MAR - 7 1997

WATER RESOURCES DEPT.
SALEM, OREGON

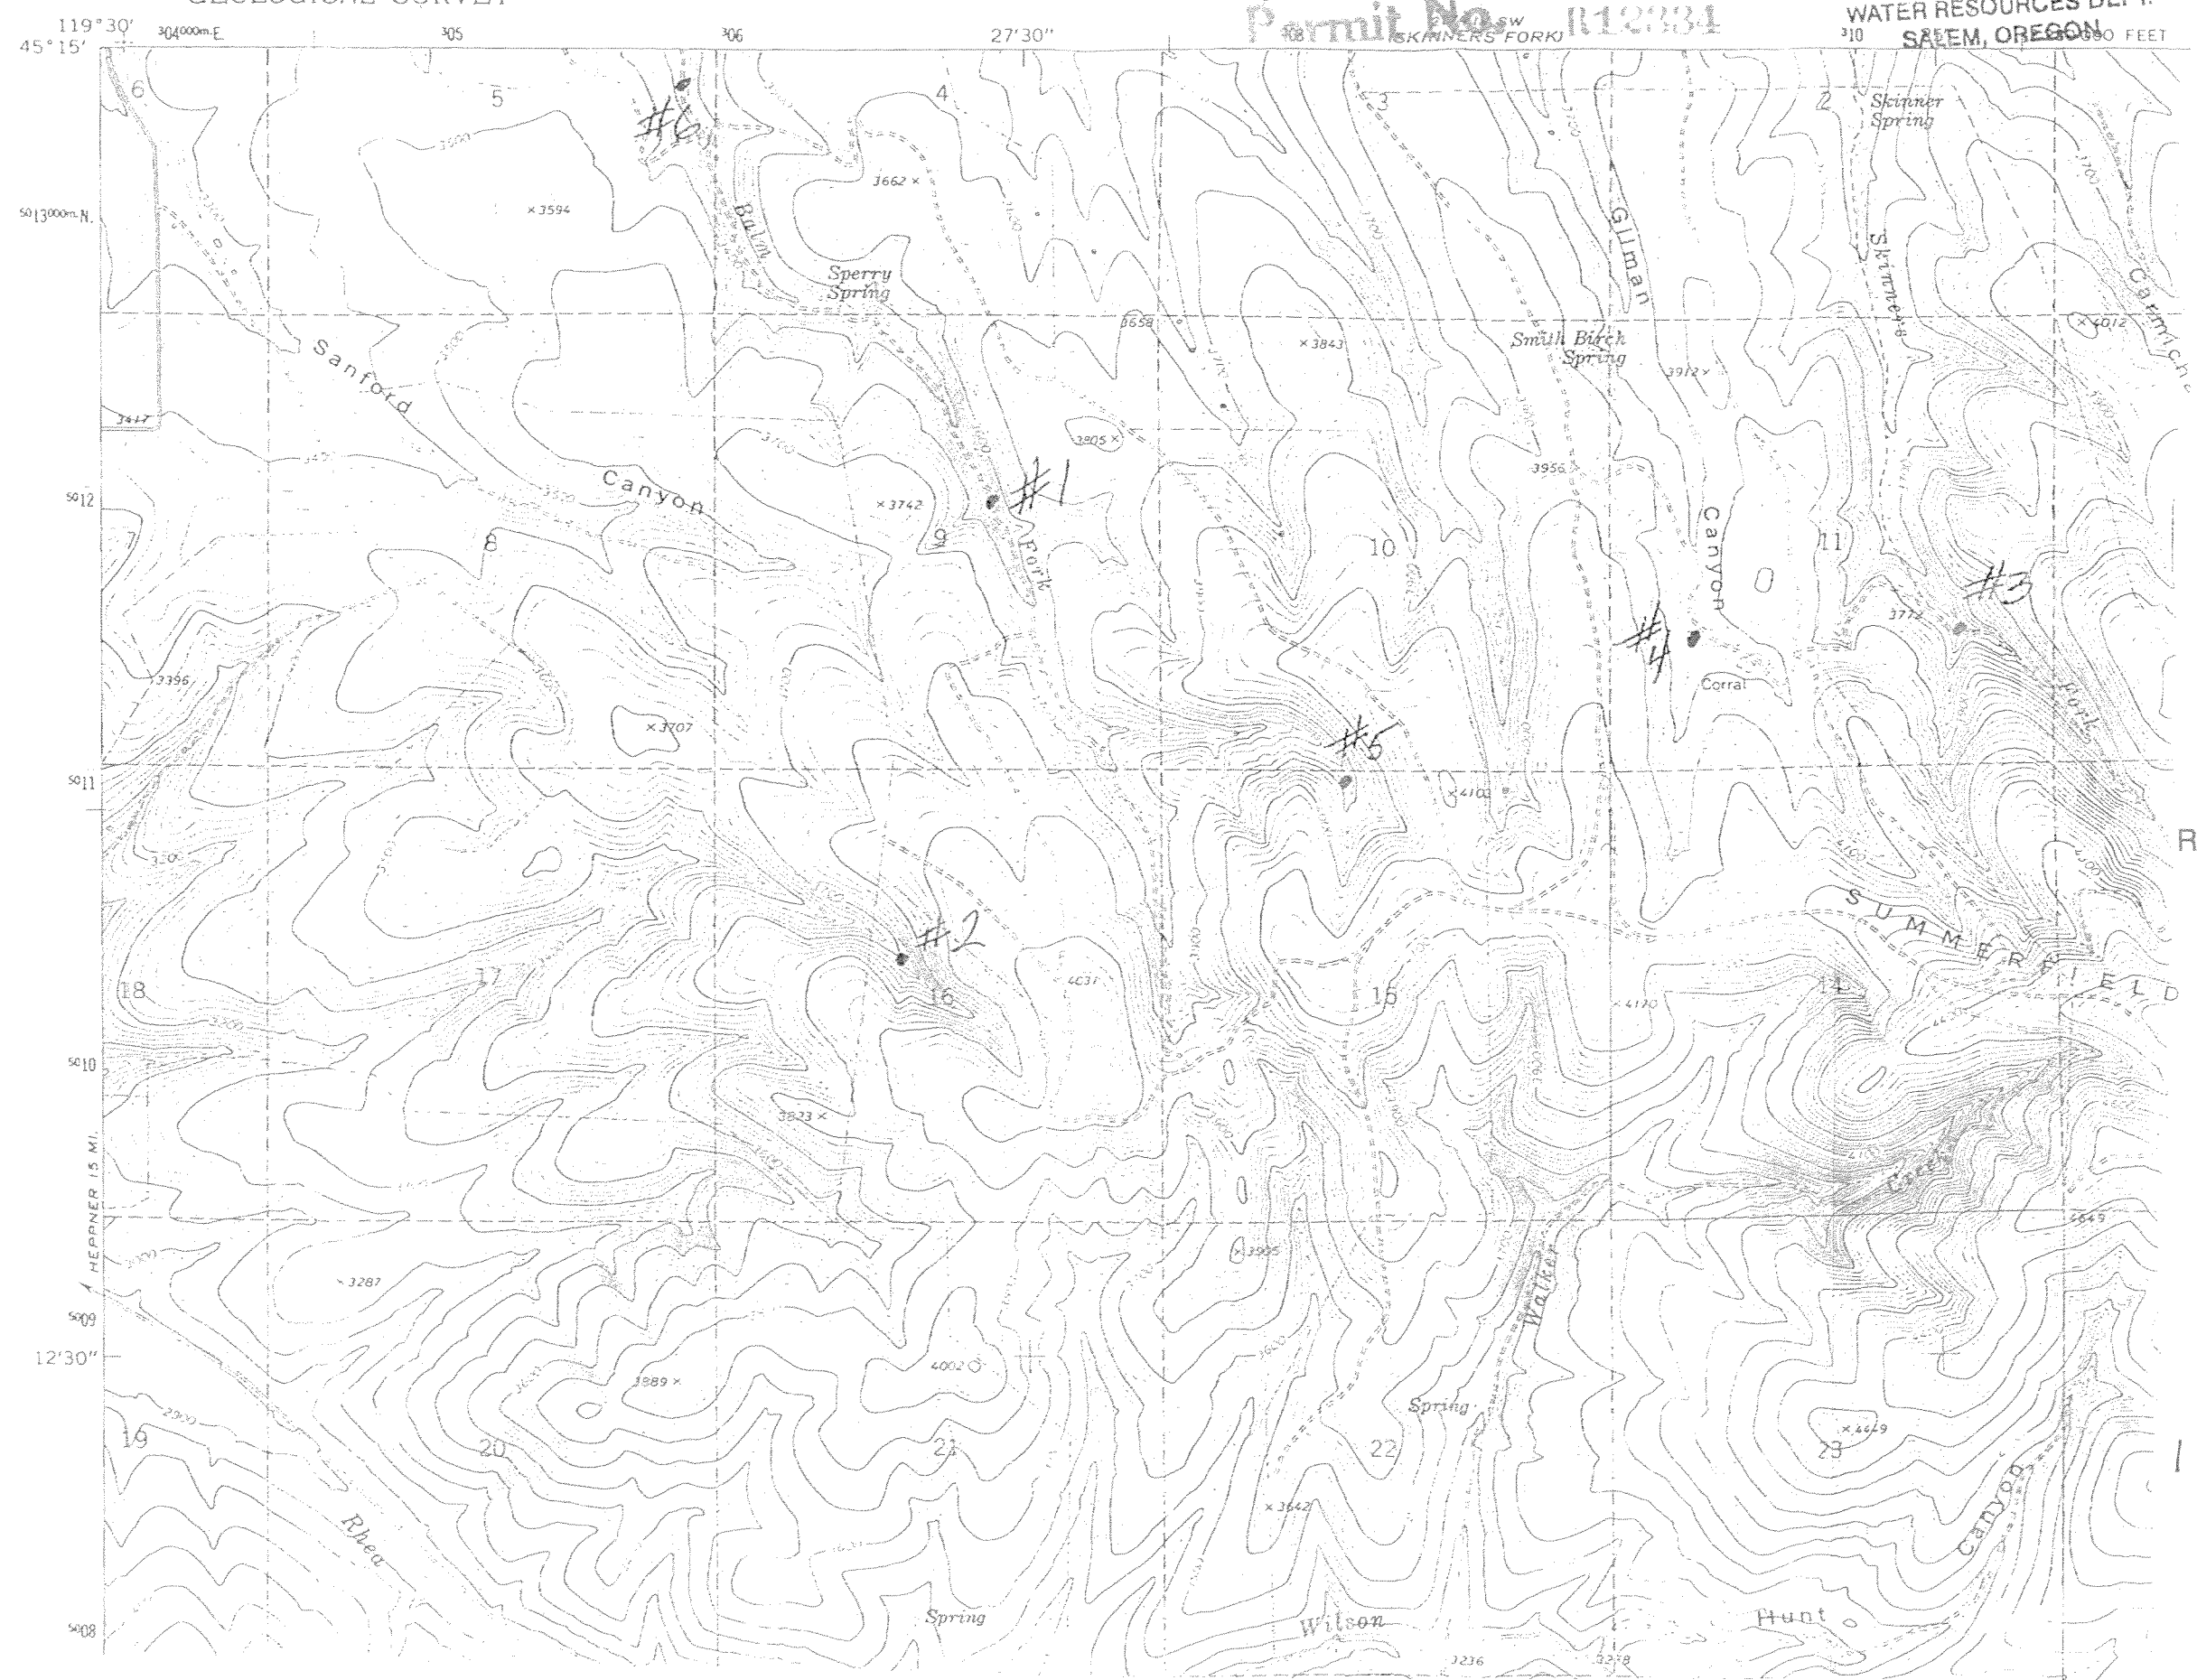

RECEIVED BY OWRD

OCT 05 2015

SALEM, OR



1 inch = 2,030 ft