

35-27E

RECEIVED BY OWRD


OCT 05 2015

SALEM, OR



RECEIVED
FEB 25 1997
WATER RESOURCES DEPT.
SALEM, OREGON

N

1 inch = 2,030 ft.

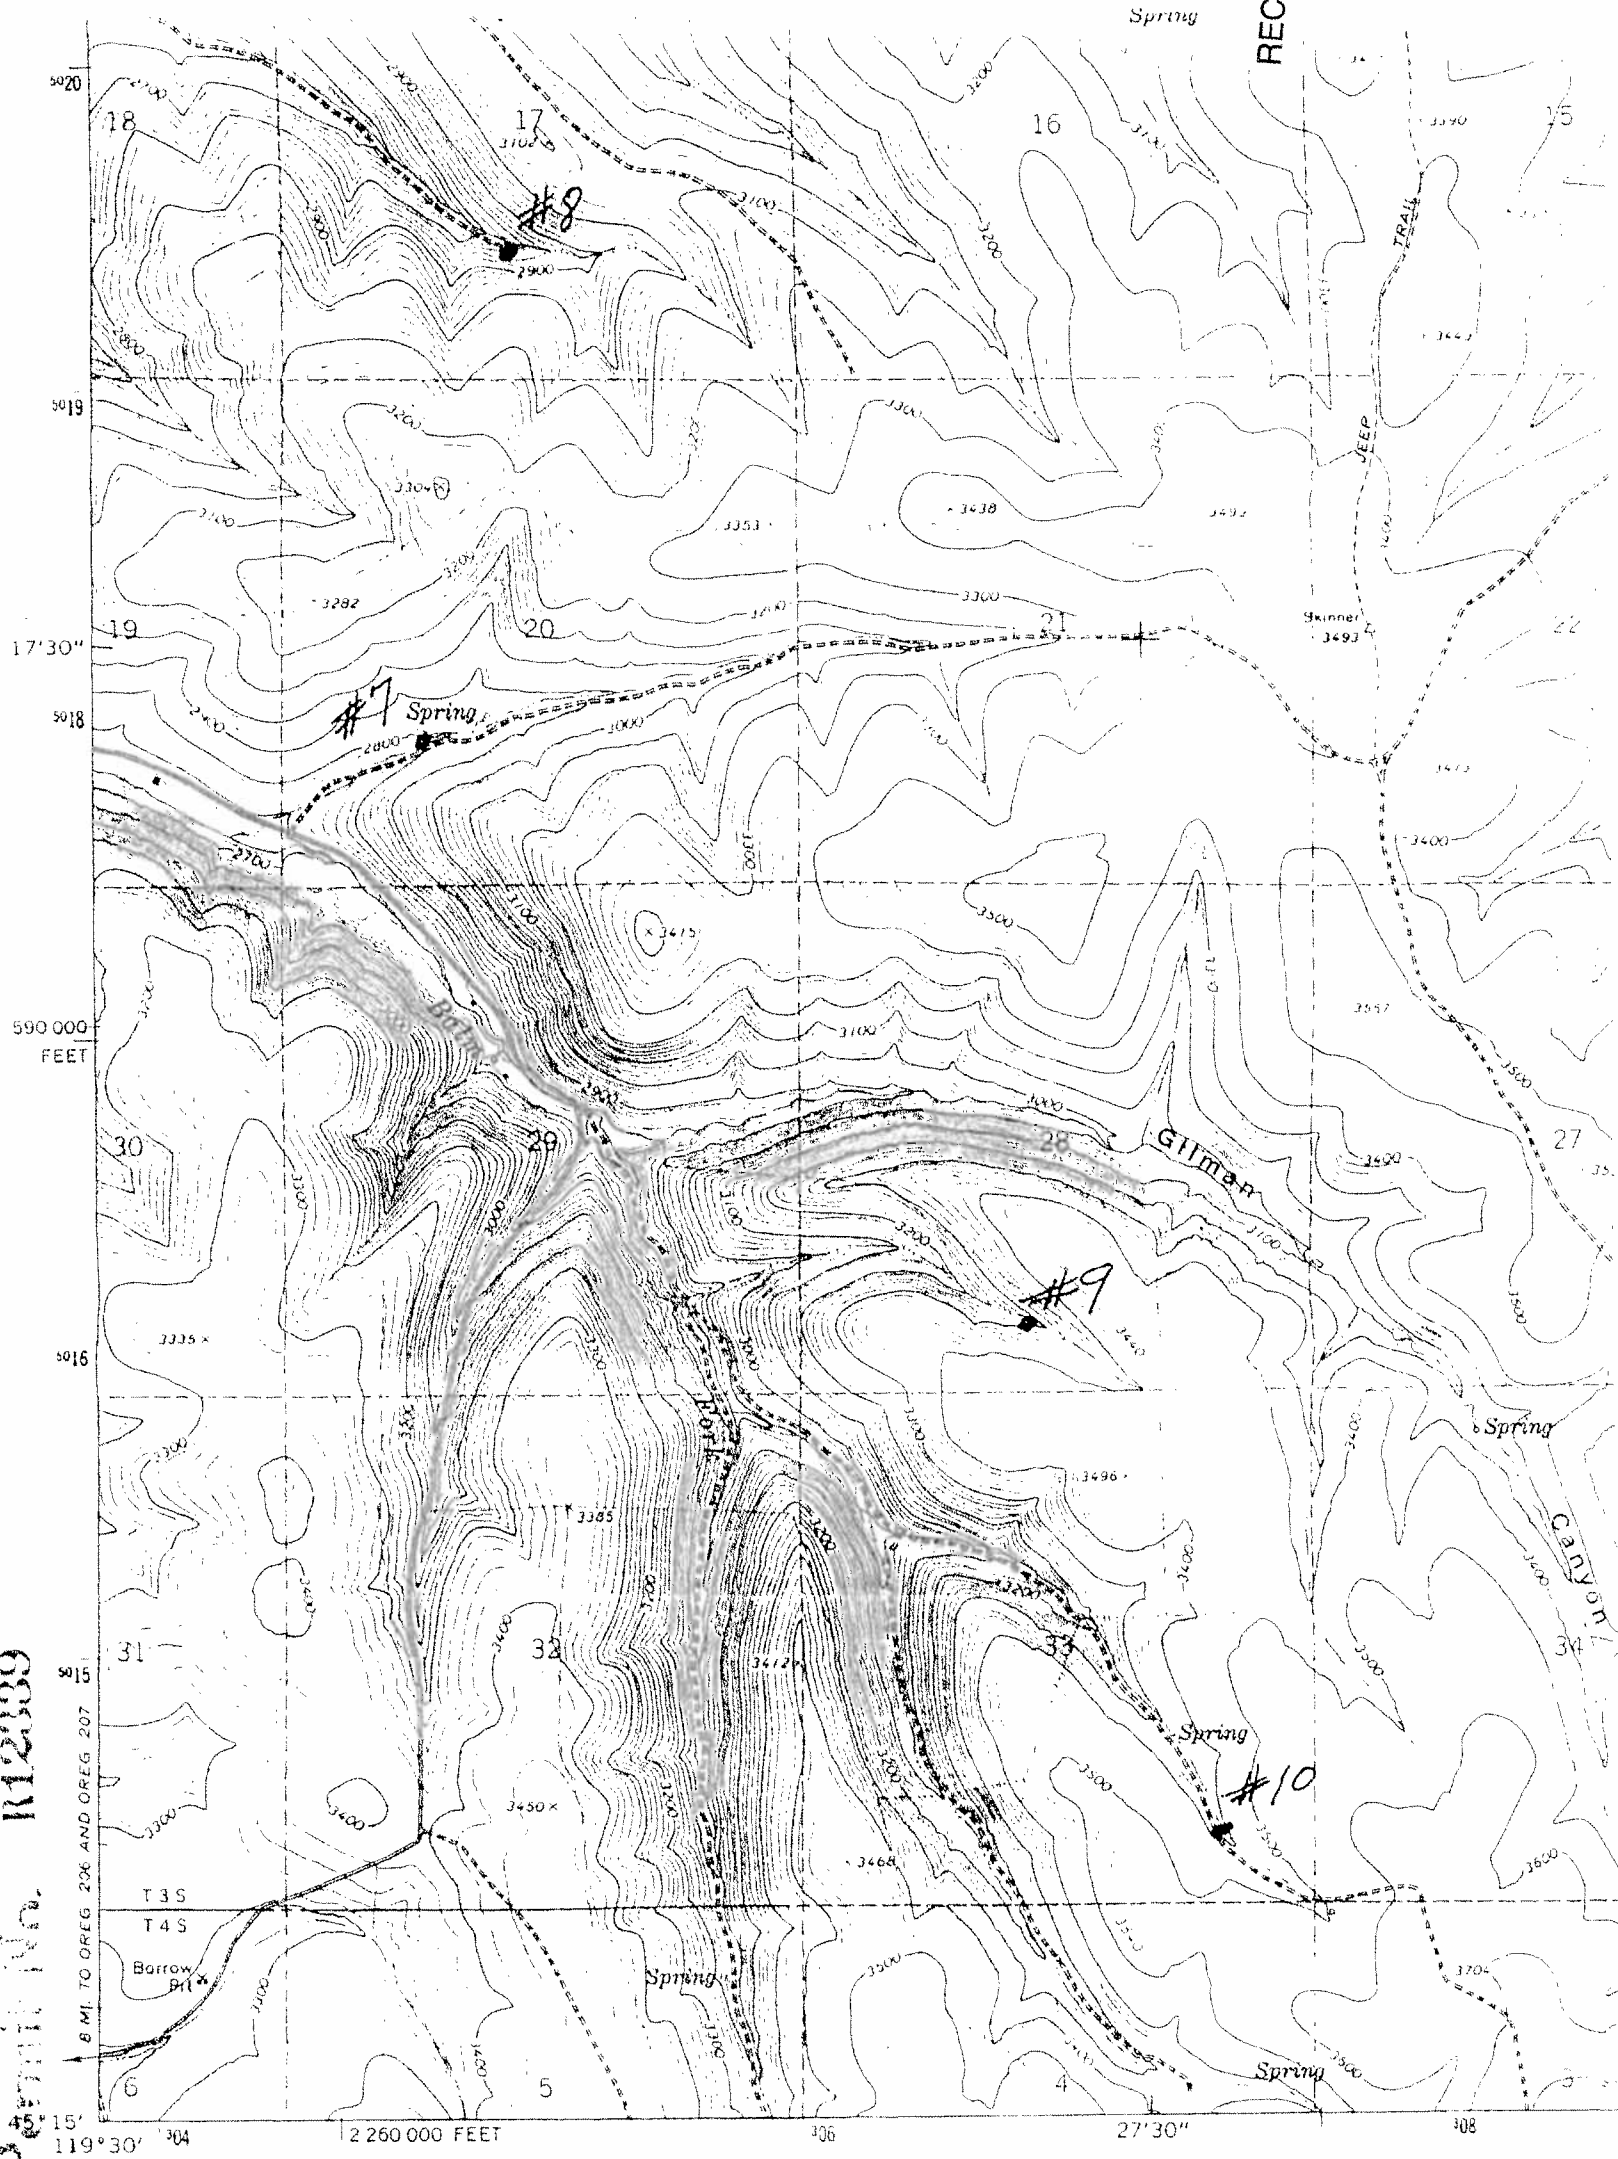

Mapped, edited, and published by the Geological Survey
Control by USGS and USC&GS
Topography by photogrammetric methods from aerial
photographs taken 1965. Field checked 1968
Polyconic projection. 1927 North American datum
10,000-foot grid based on Oregon coordinate system,
north zone
1000-meter Universal Transverse Mercator grid ticks,
zone 11, shown in blue
Fine red dashed lines indicate selected fence lines

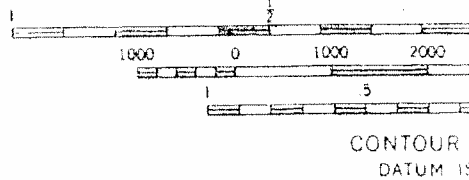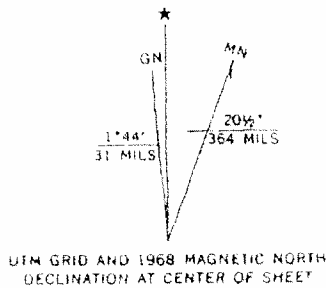

THIS MAP COMPLIES WITH /
FOR SALE BY U.S. GEOLOGICAL SURVEY, DE
A FOLDER DESCRIBING TOPOGRAPHIC