


35-27E



RECEIVED  
FEB 25 1997  
WATER RESOURCES DEPT.  
SALEM, OREGON

2

1 inch = 2,030 ft.

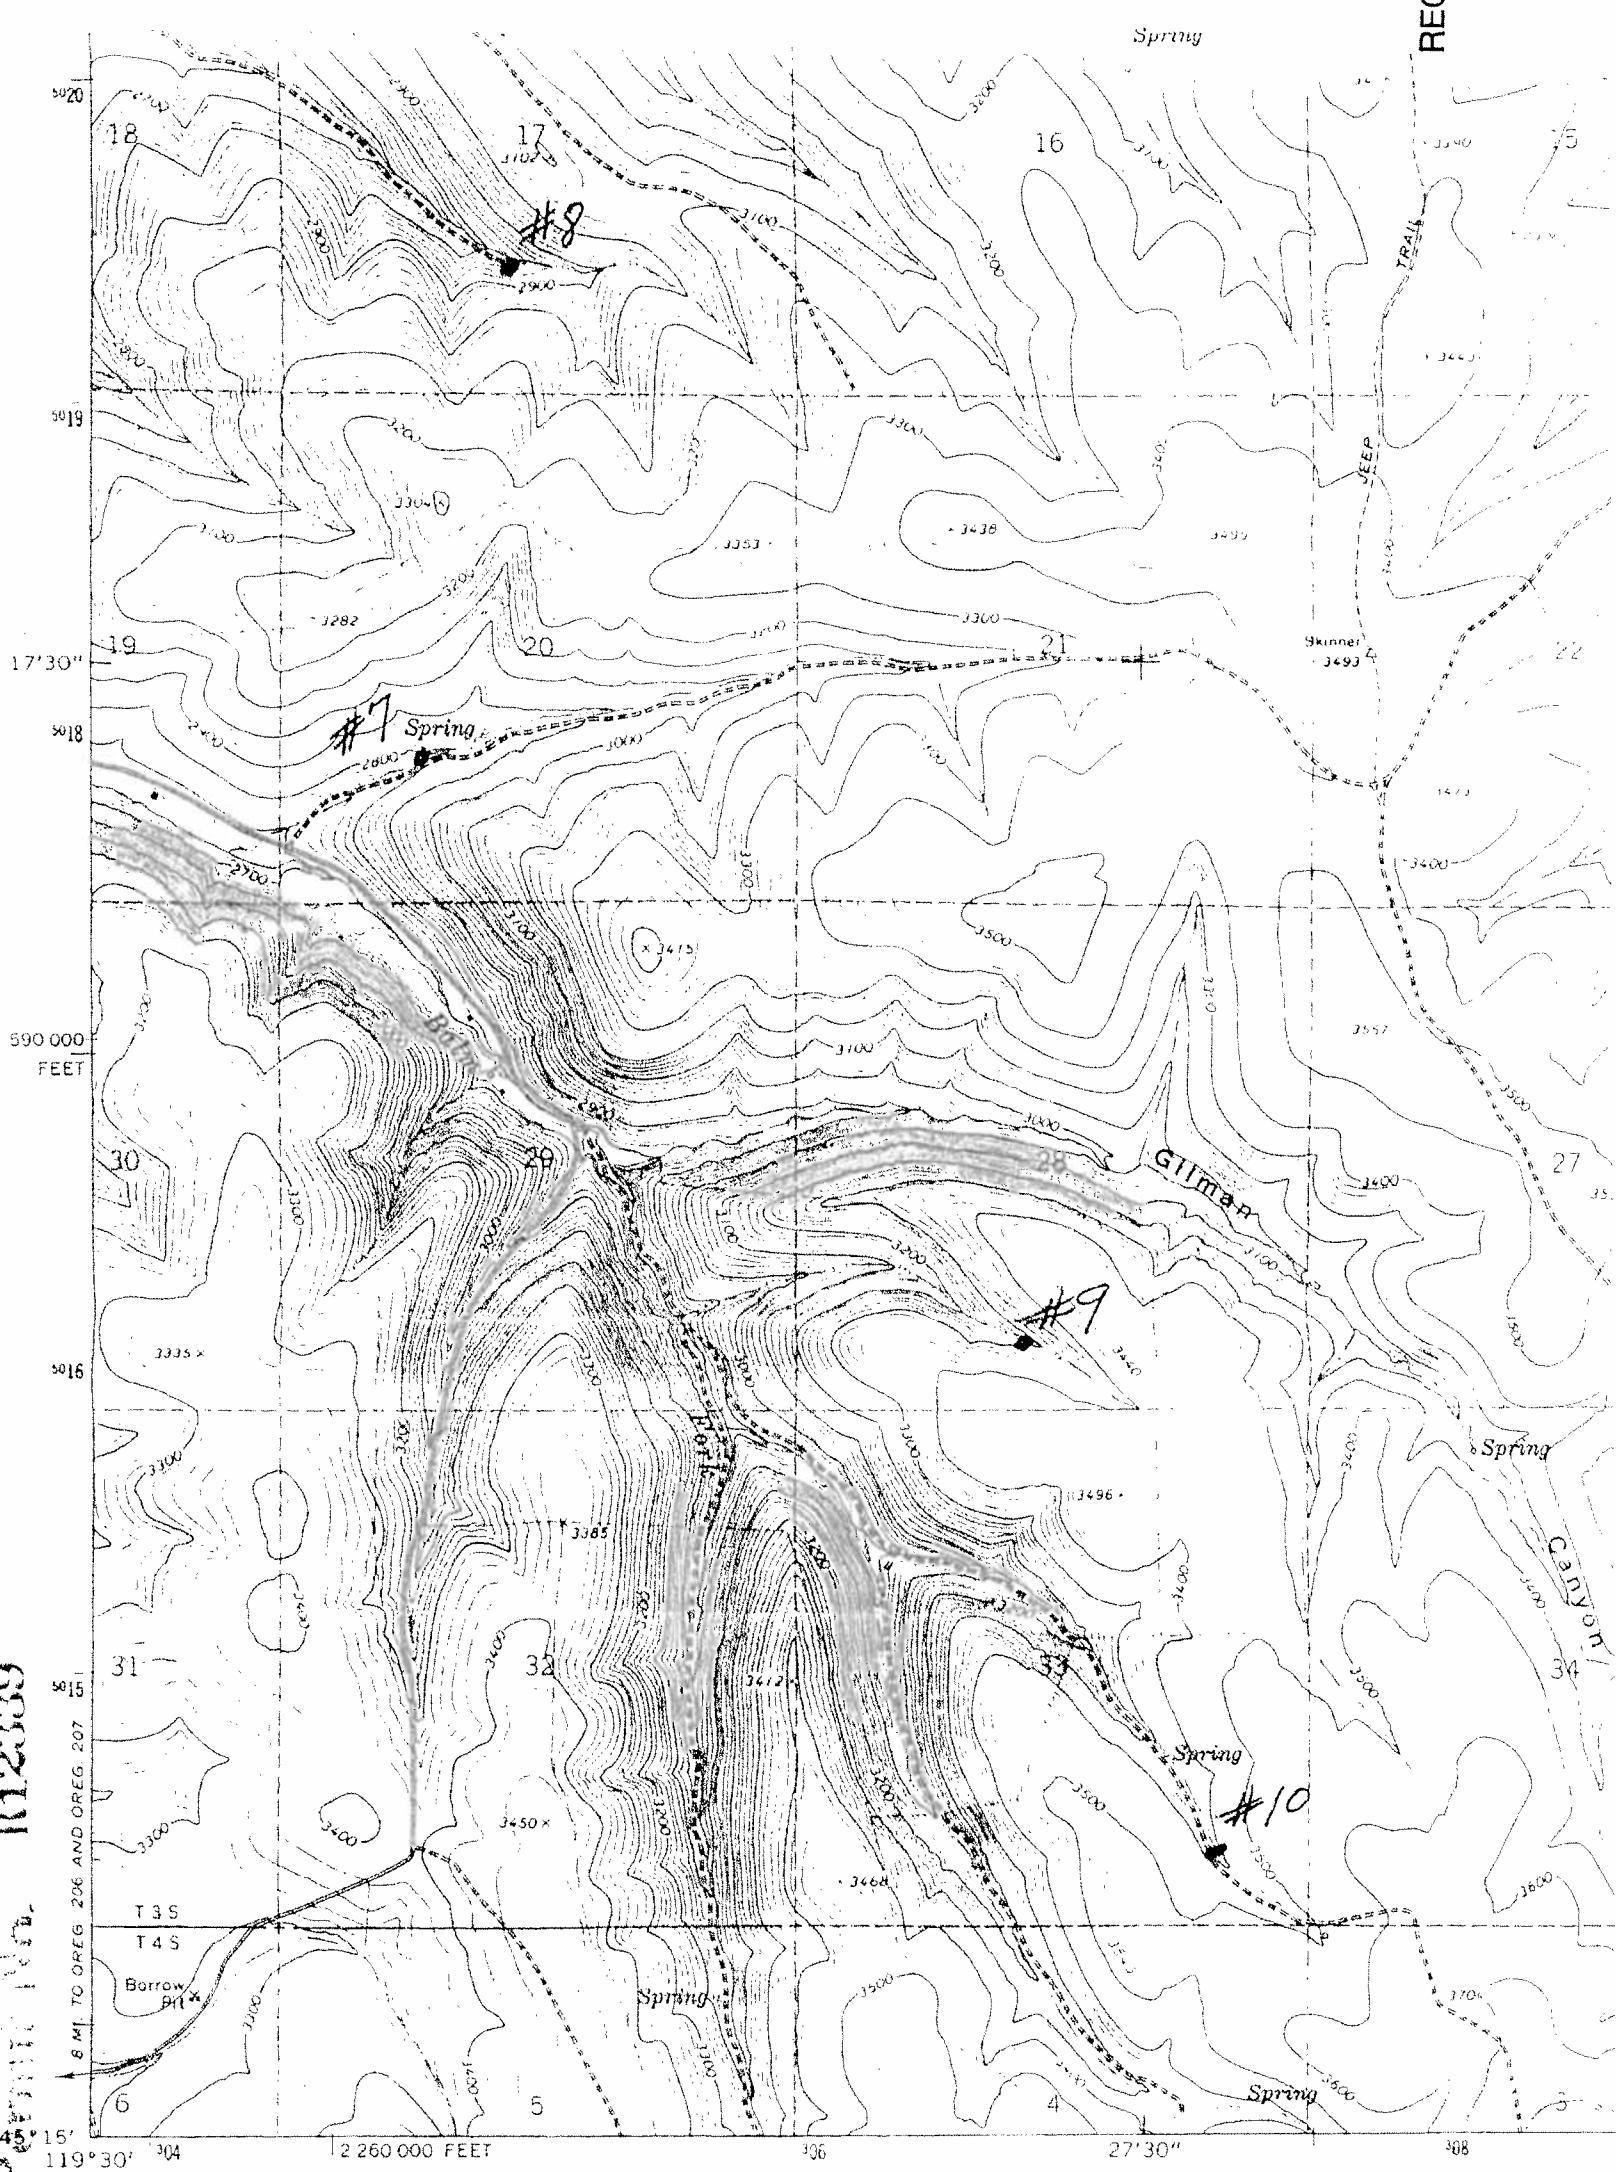

Mapped, edited, and published by the Geological Survey  
Control by USGS and USC&GS  
Topography by photogrammetric methods from aerial  
photographs taken 1965. Field checked 1968  
Polyconic projection. 1927 North American datum  
10,000-foot grid based on Oregon coordinate system,  
north zone  
1000-meter Universal Transverse Mercator grid ticks,  
zone 11, shown in blue  
Fine red dashed lines indicate selected fence lines

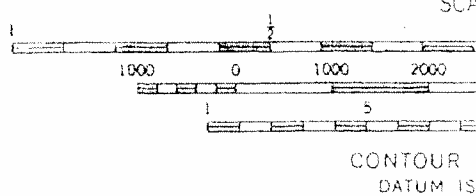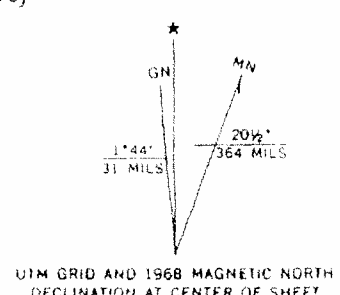

THIS MAP COMPLIES WITH A  
FOR SALE BY U.S. GEOLOGICAL SURVEY, DE  
A FOLDER DESCRIBING TOPOGRAPHIC

RECEIVED BY OWRD  
OCT 05 2015  
SALEM, OR