

20741 SE
HEPPNER

UNITED STATES
DEPARTMENT OF THE INTERIOR
GEOLOGICAL SURVEY

128253

45


27E

Application No. R82571
Permit No. R12331

RECEIVED

MAR - 7 1997


WATER RESOURCES DEPT.
SALEM, OREGON

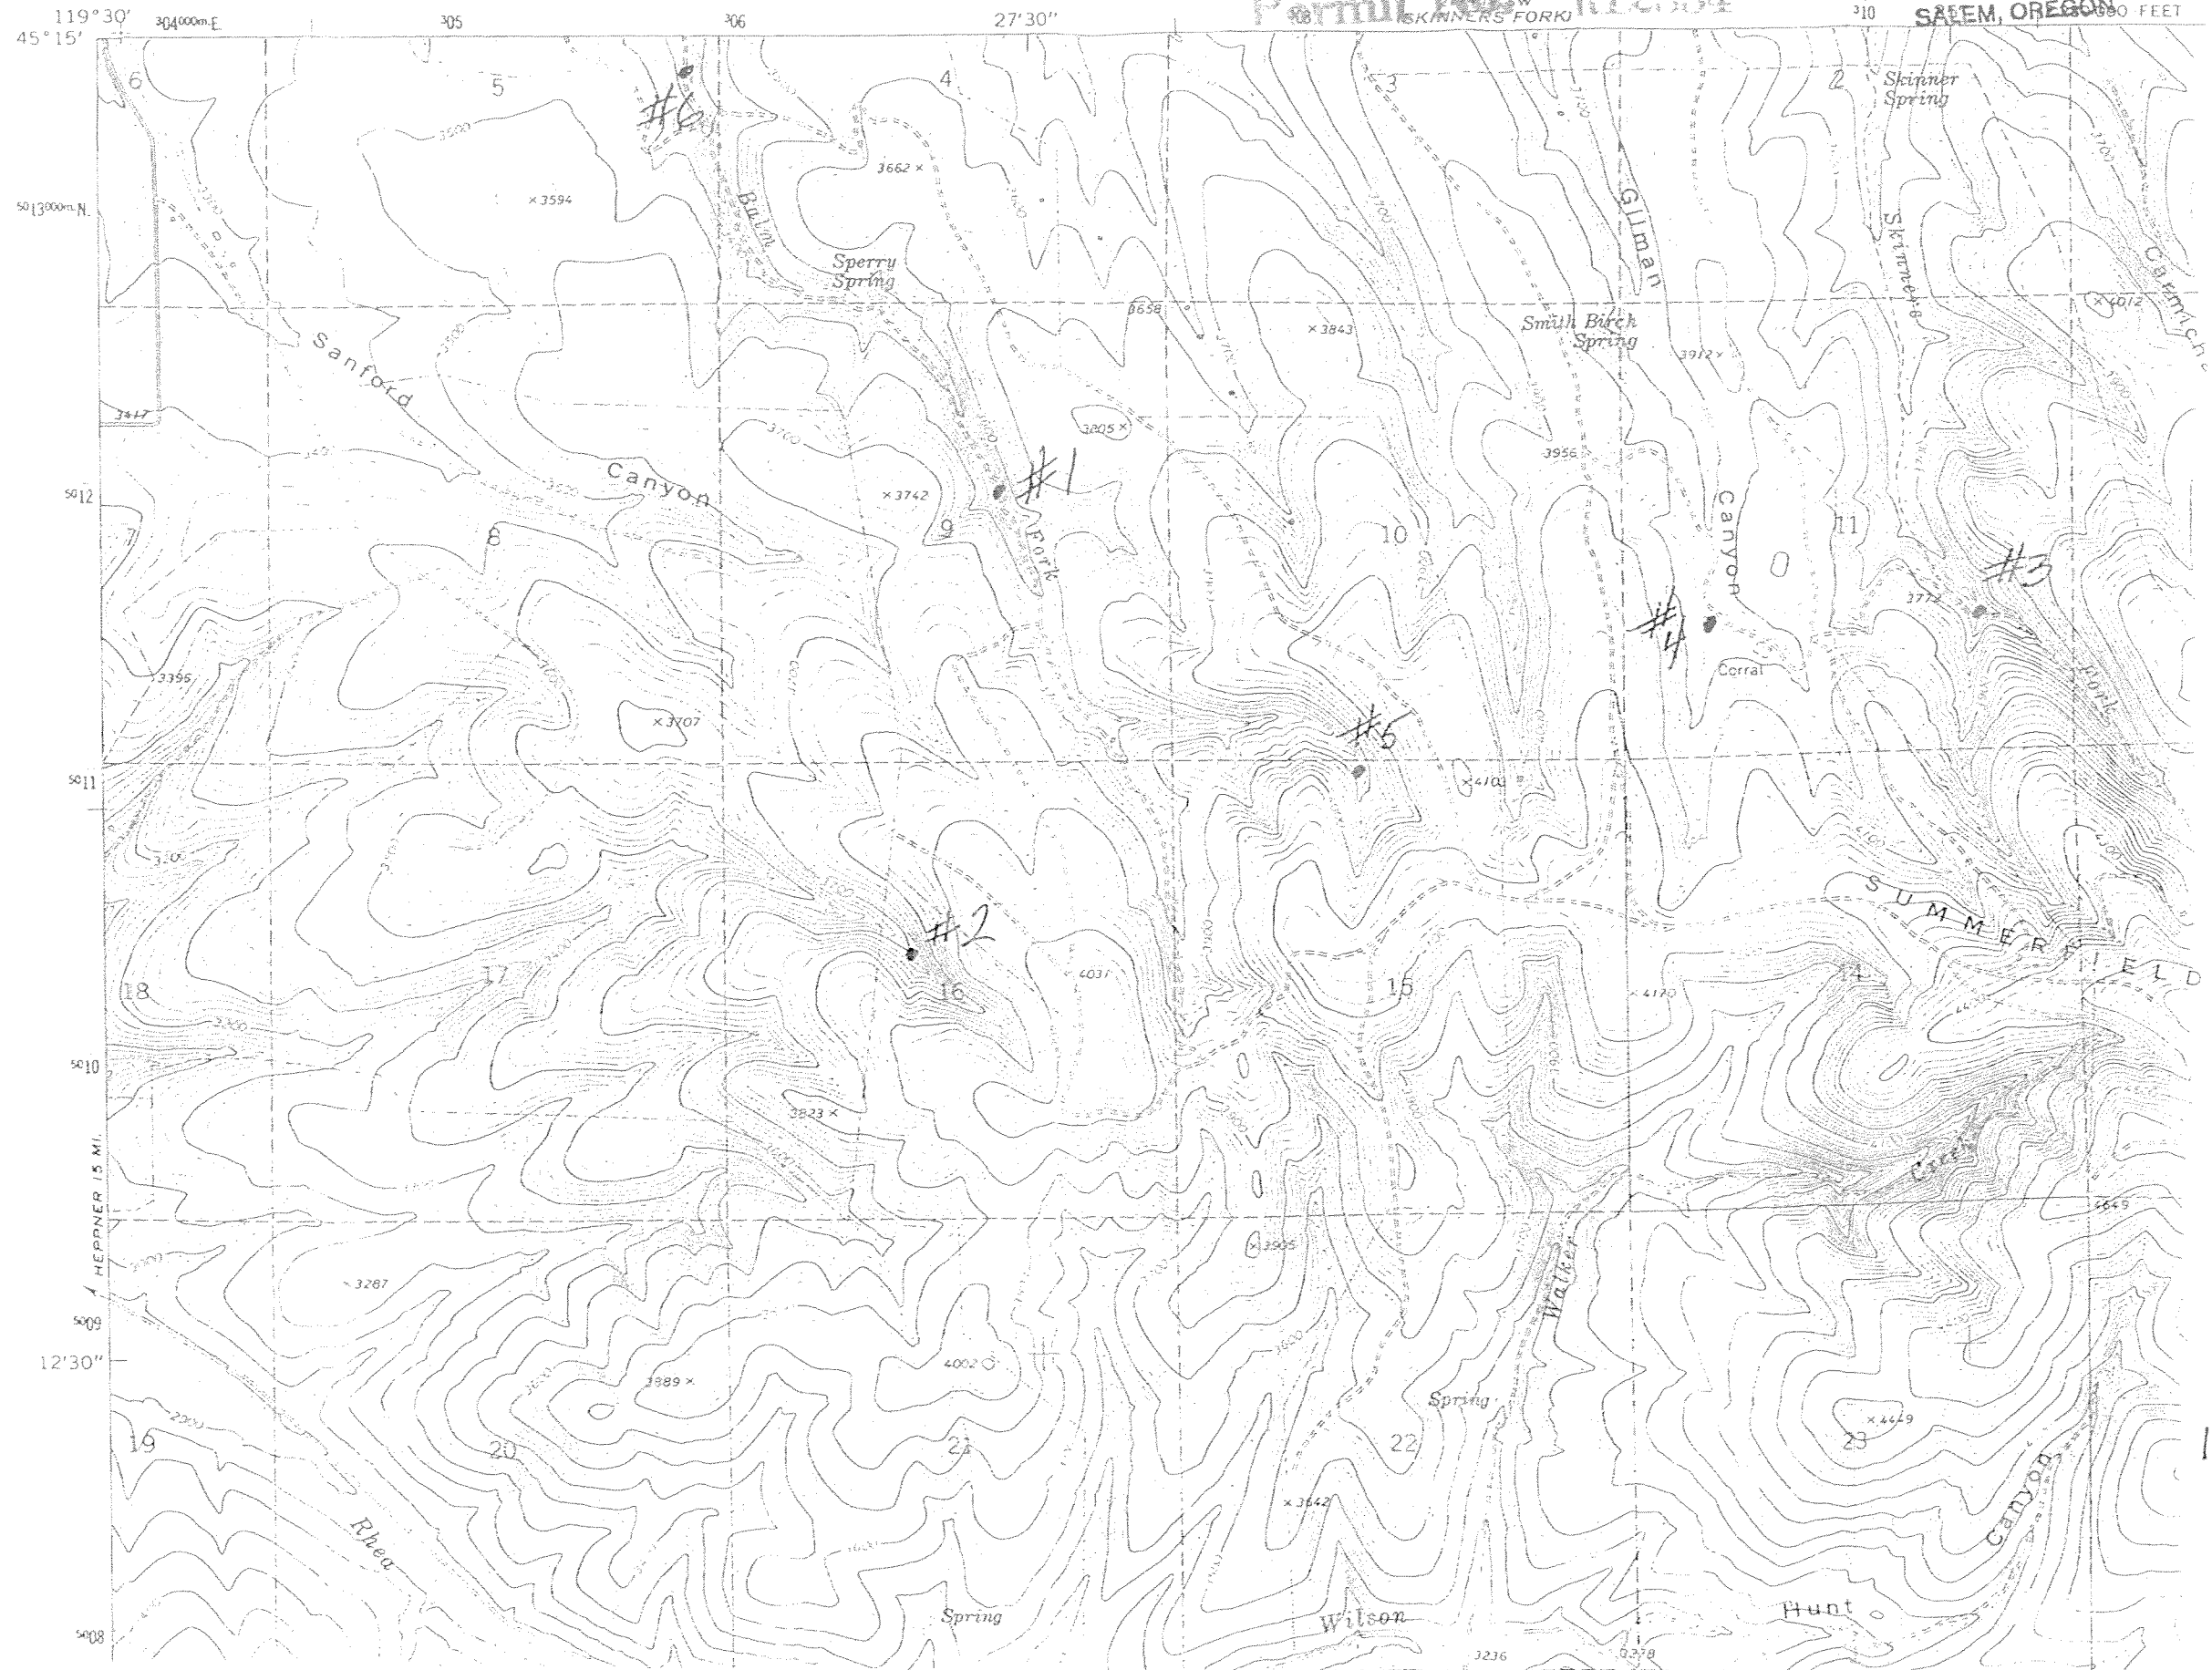

RECEIVED BY OWRD

OCT 05 2015

SALEM, OR

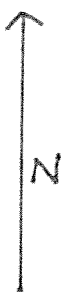

1 inch = 2,030 feet