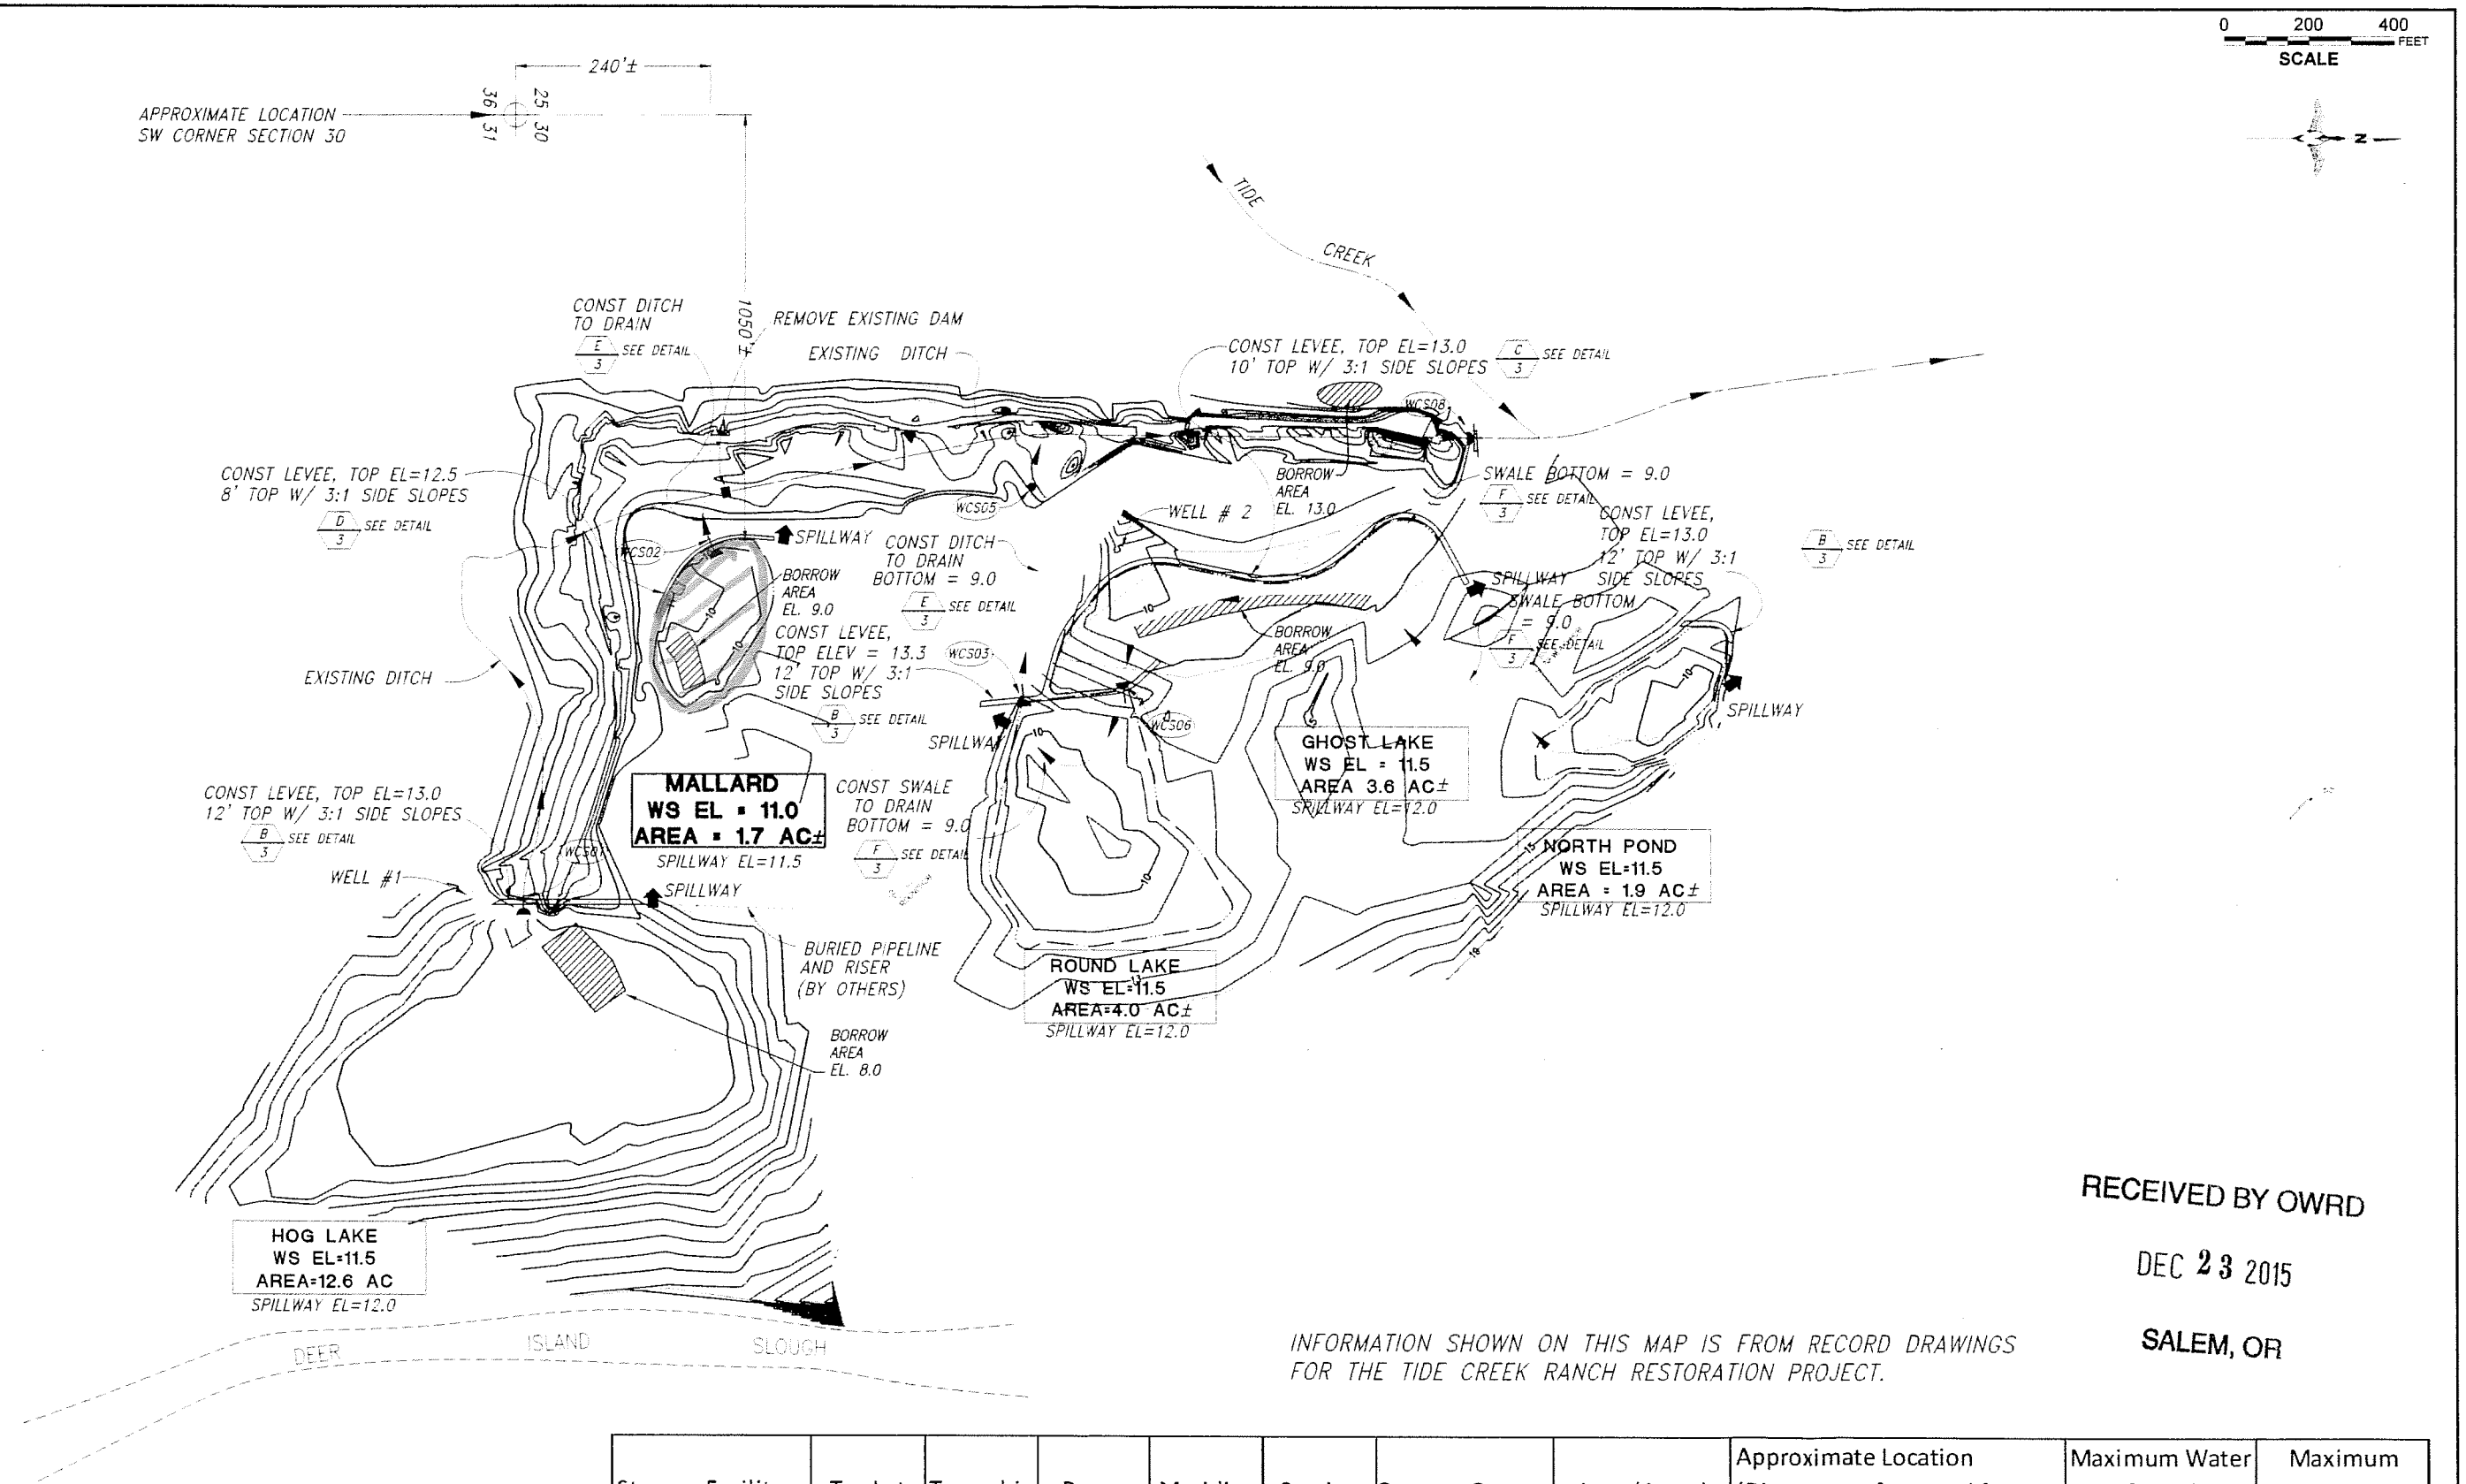


RECEIVED BY OWRD

DEC 23 2015

SALEM, OR

INFORMATION SHOWN ON THIS MAP IS FROM RECORD DRAWINGS FOR THE TIDE CREEK RANCH RESTORATION PROJECT.

Storage Facility	Tax Lot	Township	Range	Meridian	Section	Quarter-Quarter	Area (Acres)	Approximate Location (Distances referenced from SW corner Section 30)	Maximum Water Surface Elev. (Feet, NAVD 88)	Maximum Storage Volume (AC-
Mallard Reservoir	300	6N	~~1E~~ W	W.M.	30	NW 1/4 SW 1/4	1.7	240 feet north; 1050 feet east	11.0	2.6

Map amended by OWRD to identify the correct range.
CR 7.25.16

TIDE CREEK Ranch 091615
Datum and Control:
Horizontal: Oregon State Plane North Zone NAD_83(2011)(EPOCH:2010.0000)
Vertical: NAVD 88 (Computed using GEOID12B)
Units: International Feet
Horizontal/Vertical Control by two 5+ hour GPS Static observations submitted to NGS OPUS (Computed using GEOID12B)

RECORD DRAWING

Unauthorized Changes & Uses
The engineer preparing these plans will not be responsible for, or liable for, unauthorized changes to or uses of these plans. All changes must be in writing and must be approved by the preparer of these plans.

Utility Notification Center
CALL BEFORE YOU DIG

DUCKS UNLIMITED

PROJECT NO US-OR-41-1 DATE 12/1/2015 DESIGNED BY SWL
TIDE CREEK RANCH DRAWN BY DMC
SURVEYED BY
CHECKED BY
MALLARD RESERVOIR SHEET NO 1 of 1