


**T.5S. R.2E.
Sec. 34, W.M.**


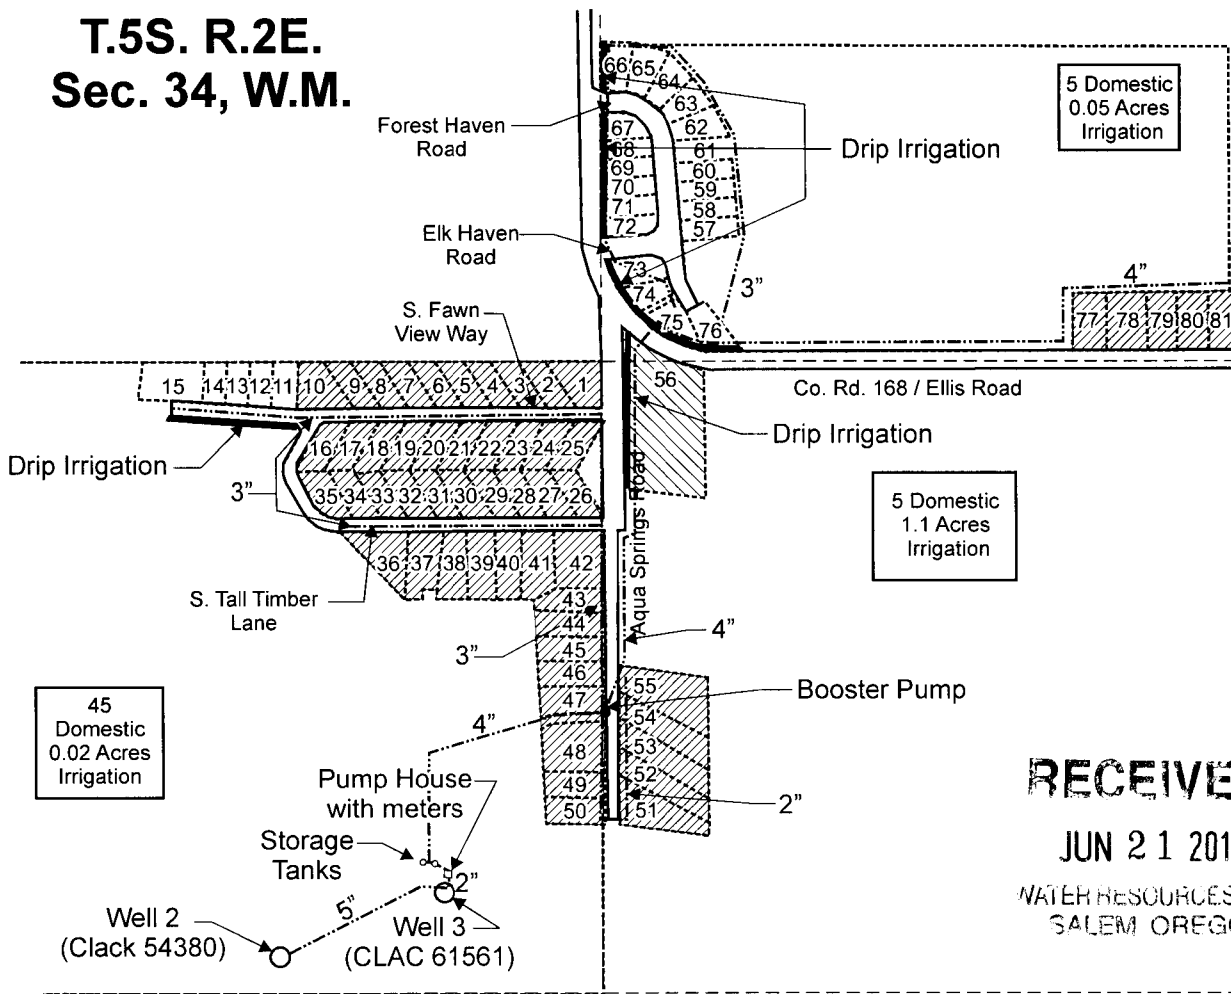


RECEIVED
JUN 21 2012
 WATER RESOURCES DEPT
 SALEM OREGON

Well 2 (CLAC 54380) is located 1,390 feet north and 1,985 feet west from the SE corner of Section 34.
 Well 3 (CLAC 61561) is located 1,535 feet north and 1,660 feet west from the SE corner of Section 34.

- Group Domestic Expanded area (55 sites)
- Field area (1.10 Acres) irrigated under Application G-14632, Permit G-13527.
- Strip areas (0.07 Acre) drip-irrigated under Application G-14632, Permit G-13527.
- Tax lot boundary
- Water Mainline

Scale: 1" = 400'

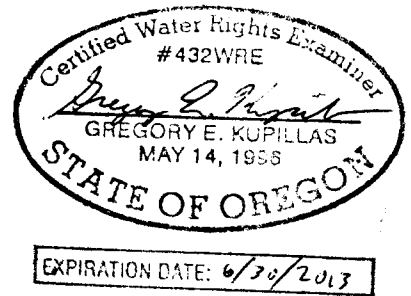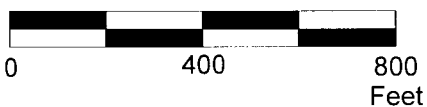

34 35
3 2

This map was prepared for the purpose of identifying the location of a water right only and is not intended to provide legal dimensions or location of property ownership lines.

Pacific Hydro-Geology Inc.

Claim of Beneficial Use Map
Application G-14632; Permit G-13527

Thomas F. & Donna V. Fitzpatrick
 T.5S. R.2E. Section 34, W.M.

Fitzpatrick_COBUmap.cdr

T.5S. R.2E Section 34, W.M.

- 1. TL 5 2E 34DB 0100
- 2. TL 5 2E 34DB 0200
- 3. TL 5 2E 34DB 0300
- 4. TL 5 2E 34DB 0400
- 5. TL 5 2E 34DB 0500
- 6. TL 5 2E 34DB 0600
- 7. TL 5 2E 34DB 0700
- 8. TL 5 2E 34DB 0800
- 9. TL 5 2E 34DB 0900
- 10. TL 5 2E 34DB 1000

- 67. TL 5 2E 34AD 1200
- 68. TL 5 2E 34AD 1300
- 69. TL 5 2E 34AD 1400
- 70. TL 5 2E 34AD 1500
- 71. TL 5 2E 34AD 1600
- 72. TL 5 2E 34AD 1700

- 62. TL 5 2E 34AD 0700
- 63. TL 5 2E 34AD 0800
- 64. TL 5 2E 34AD 0900
- 65. TL 5 2E 34AD 1000
- 66. TL 5 2E 34AD 1100

- 73. TL 5 2E 34AD 1800
- 74. TL 5 2E 34AD 1900
- 75. TL 5 2E 34AD 2000
- 76. TL 5 2E 34AD 2100

- 57. TL 5 2E 34AD 0200
- 58. TL 5 2E 34AD 0300
- 59. TL 5 2E 34AD 0400
- 60. TL 5 2E 34AD 0500

- 11. TL 5 2E 34DB 1100
- 12. TL 5 2E 34DB 1200
- 13. TL 5 2E 34DB 1300
- 14. TL 5 2E 34DB 1400
- 15. TL 5 2E 34DB 1500

- 16. TL 5 2E 34DB 1600
- 17. TL 5 2E 34DB 1700
- 18. TL 5 2E 34DB 1800
- 19. TL 5 2E 34DB 1900
- 20. TL 5 2E 34DB 2000
- 21. TL 5 2E 34DB 2100
- 22. TL 5 2E 34DB 2200
- 23. TL 5 2E 34DB 2300
- 24. TL 5 2E 34DB 2400
- 25. TL 5 2E 34DB 2500

- 16
- 17
- 18
- 19
- 20
- 21
- 22
- 23
- 24
- 25
- 35
- 34
- 33
- 32
- 31
- 30
- 29
- 28
- 27
- 26

- 26. TL 5 2E 34DB 2600
- 27. TL 5 2E 34DB 2700
- 28. TL 5 2E 34DB 2800
- 29. TL 5 2E 34DB 2900
- 30. TL 5 2E 34DB 3000
- 31. TL 5 2E 34DB 3100
- 32. TL 5 2E 34DB 3200
- 33. TL 5 2E 34DB 3300
- 34. TL 5 2E 34DB 3400
- 35. TL 5 2E 34DB 3500

- 77. TL 5 2E 34AD 2600
- 78. TL 5 2E 34AD 2500
- 79. TL 5 2E 34AD 2400
- 80. TL 5 2E 34AD 2300
- 81. TL 5 2E 34AD 2200

- 43
- 44
- 45
- 46
- 47
- 48
- 49
- 50
- 51
- 52
- 53
- 54
- 55


- 36. TL 5 2E 34DB 3600
- 37. TL 5 2E 34DB 3700
- 38. TL 5 2E 34DB 3800
- 39. TL 5 2E 34DB 3900
- 40. TL 5 2E 34DB 4000
- 41. TL 5 2E 34DB 4100
- 42. TL 5 2E 34DB 4200
- 43. TL 5 2E 34DB 4300

- 44. TL 5 2E 34DB 4400

- 45. TL 5 2E 34DB 4500
- 46. TL 5 2E 34DB 4600
- 47. TL 5 2E 34DB 4700
- 48. TL 5 2E 34DB 4900
- 49. TL 5 2E 34DB 5000
- 50. TL 5 2E 34DB 5100

- 55. TL 5 2E 34DB 5600
- 54. TL 5 2E 34DB 5500
- 53. TL 5 2E 34DB 5400
- 52. TL 5 2E 34DB 5300
- 51. TL 5 2E 34DB 5200


RECEIVED
JUN 21 2012
 WATER RESOURCES DEPT.
 SALEM, OREGON

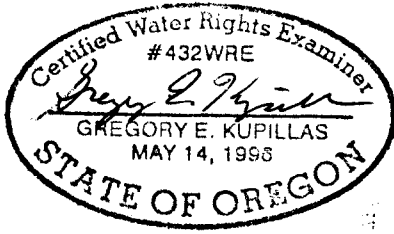

EXPIRATION DATE: 6/30/2013

----- Tax lot boundary

Scale: 1" = 400'

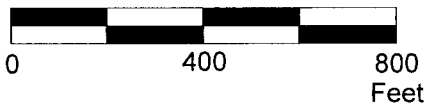

34 35
3 2

This map was prepared for the purpose of identifying the location of a water right only and is not intended to provide legal dimensions or location of property ownership lines.

Tax Lot Location Map Application G-14632; Permit G-13527

Thomas F. & Donna V. Fitzpatrick
 T.5S. R.2E. Section 34, W.M.

Pacific Hydro-Geology Inc.

Fitzpatrick_COBUmap.cdr