


T.5S. R.2E Section 34, W.M.


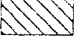


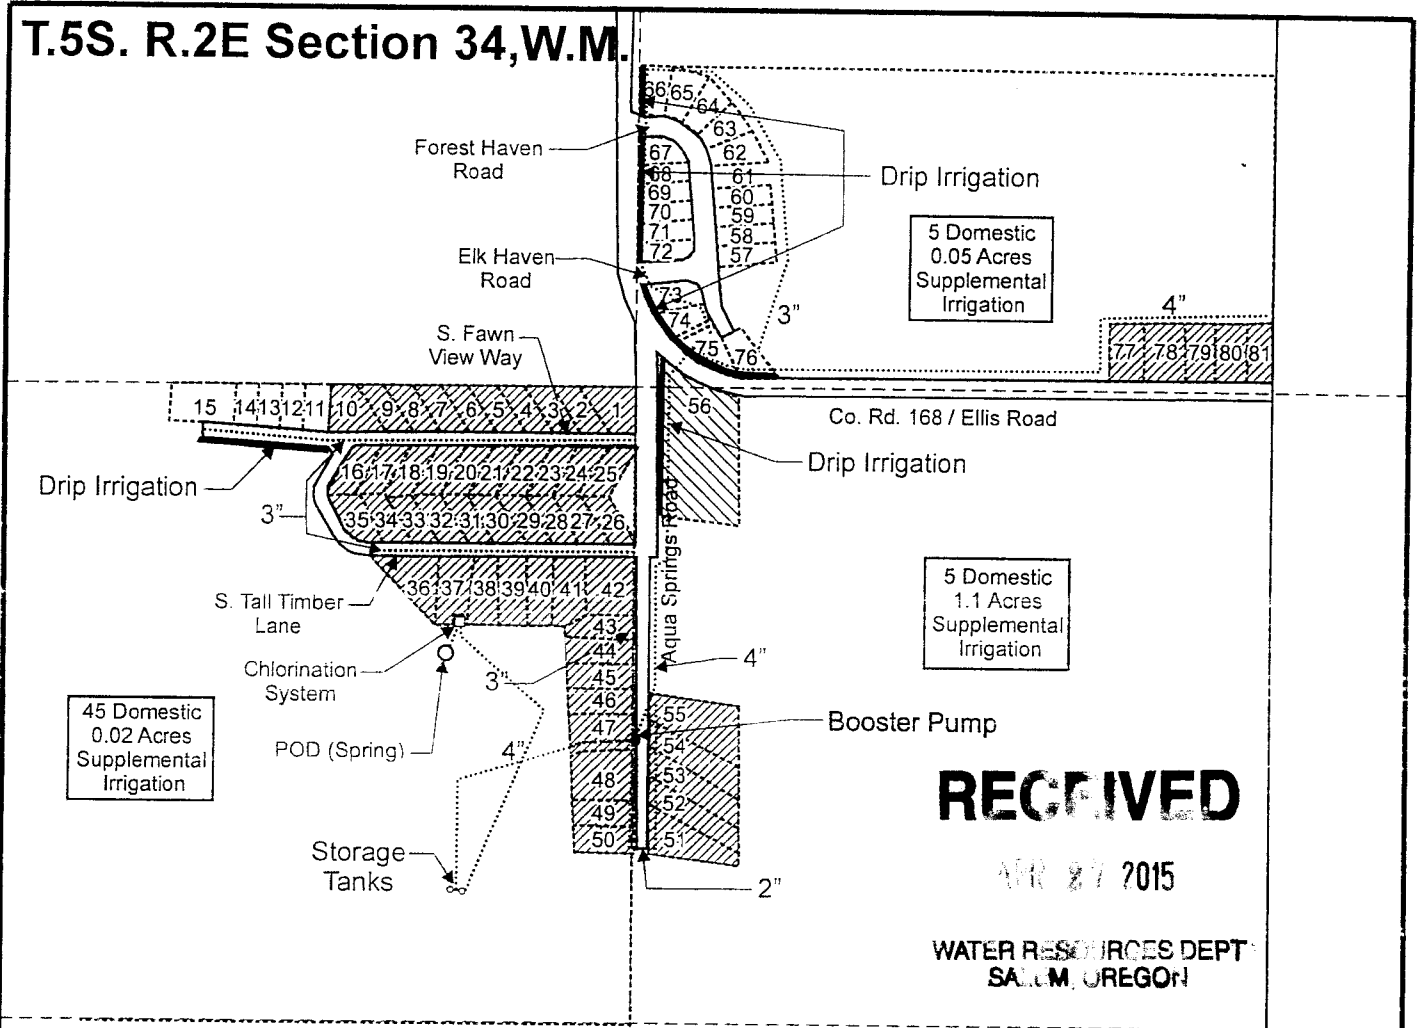


RECEIVED



APR 27 2015

WATER RESOURCES DEPT

Point of diversion (spring) is located 2,080 feet north and 1,700 feet west of the SE corner, Section 34.

-  Supplemental Group Domestic area (55 sites) under App S-83594, Permit S-53495
-  Field area (1.10 Acres) supplemental irrigation under App S-83594, Permit S-53495
-  Strip area (0.07 Acres) supplemental drip-irrigation under App S-83594, Permit S-53495
-  Tax lot boundary
-  Water Mainline

Scale: 1" = 400'

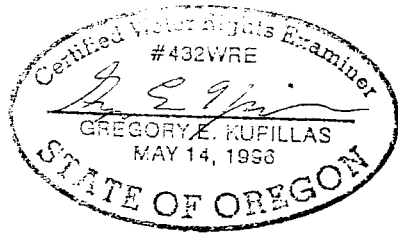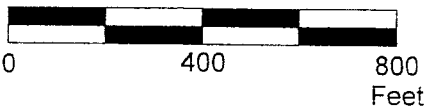

EXPIRATION DATE: 6/30/2015



34 35
3 2

This map was prepared for the purpose of identifying the location of a water right only and is not intended to provide legal dimensions or location of property ownership lines.

Pacific Hydro-Geology Inc.

Claim of Beneficial Use Map
Application S-83594, Permit S-53495

Thomas F. & Donna V. Fitzpatrick
T.5S. R.2E. Section 34, W.M.

Fitzpatrick_COBUmap.cdr

T.5S. R.2E Section 34, W.M

- 1. TL 5 2E 34DB 0100
- 2. TL 5 2E 34DB 0200
- 3. TL 5 2E 34DB 0300
- 4. TL 5 2E 34DB 0400
- 5. TL 5 2E 34DB 0500
- 6. TL 5 2E 34DB 0600
- 7. TL 5 2E 34DB 0700
- 8. TL 5 2E 34DB 0800
- 9. TL 5 2E 34DB 0900
- 10. TL 5 2E 34DB 1000

- 67. TL 5 2E 34AD 1200
- 68. TL 5 2E 34AD 1300
- 69. TL 5 2E 34AD 1400
- 70. TL 5 2E 34AD 1500
- 71. TL 5 2E 34AD 1600
- 72. TL 5 2E 34AD 1700

- 62. TL 5 2E 34AD 0700
- 63. TL 5 2E 34AD 0800
- 64. TL 5 2E 34AD 0900
- 65. TL 5 2E 34AD 1000
- 66. TL 5 2E 34AD 1100

- 73. TL 5 2E 34AD 1800
- 74. TL 5 2E 34AD 1900
- 75. TL 5 2E 34AD 2000
- 76. TL 5 2E 34AD 2100

- 57. TL 5 2E 34AD 0200
- 58. TL 5 2E 34AD 0300
- 59. TL 5 2E 34AD 0400
- 60. TL 5 2E 34AD 0500

- 11. TL 5 2E 34DB 1100
- 12. TL 5 2E 34DB 1200
- 13. TL 5 2E 34DB 1300
- 14. TL 5 2E 34DB 1400
- 15. TL 5 2E 34DB 1500

- 16. TL 5 2E 34DB 1600
- 17. TL 5 2E 34DB 1700
- 18. TL 5 2E 34DB 1800
- 19. TL 5 2E 34DB 1900
- 20. TL 5 2E 34DB 2000
- 21. TL 5 2E 34DB 2100
- 22. TL 5 2E 34DB 2200
- 23. TL 5 2E 34DB 2300
- 24. TL 5 2E 34DB 2400
- 25. TL 5 2E 34DB 2500


- 26. TL 5 2E 34DB 2600
- 27. TL 5 2E 34DB 2700
- 28. TL 5 2E 34DB 2800
- 29. TL 5 2E 34DB 2900
- 30. TL 5 2E 34DB 3000
- 31. TL 5 2E 34DB 3100
- 32. TL 5 2E 34DB 3200
- 33. TL 5 2E 34DB 3300
- 34. TL 5 2E 34DB 3400
- 35. TL 5 2E 34DB 3500

- 77. TL 5 2E 34AD 2600
- 78. TL 5 2E 34AD 2500
- 79. TL 5 2E 34AD 2400
- 80. TL 5 2E 34AD 2300
- 81. TL 5 2E 34AD 2200

- 36. TL 5 2E 34DB 3600
- 37. TL 5 2E 34DB 3700
- 38. TL 5 2E 34DB 3800
- 39. TL 5 2E 34DB 3900
- 40. TL 5 2E 34DB 4000
- 41. TL 5 2E 34DB 4100
- 42. TL 5 2E 34DB 4200
- 43. TL 5 2E 34DB 4300

44. TL 5 2E 34DB 4400


- 45. TL 5 2E 34DB 4500
- 46. TL 5 2E 34DB 4600
- 47. TL 5 2E 34DB 4700
- 48. TL 5 2E 34DB 4900
- 49. TL 5 2E 34DB 5000
- 50. TL 5 2E 34DB 5100

- 55. TL 5 2E 34DB 5600
- 54. TL 5 2E 34DB 5500
- 53. TL 5 2E 34DB 5400
- 52. TL 5 2E 34DB 5300
- 51. TL 5 2E 34DB 5200

RECEIVED

APR 27 2015

WATER RESOURCES DEPT
SALEM, OREGON

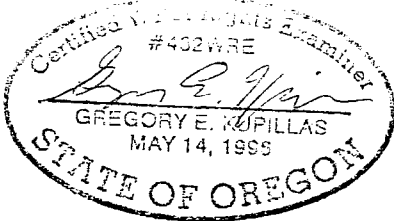

EXPIRATION DATE: 6/30/2015

----- Tax lot boundary

Scale: 1" = 400'



0 400 800
Feet

This map was prepared for the purpose of identifying the location of a water right only and is not intended to provide legal dimensions or location of property ownership lines.

Pacific Hydro-Geology Inc.

Tax Lot Location Map
Application S-83594, Permit S-53495

Thomas F. & Donna V. Fitzpatrick
T.5S. R.2E. Section 34, W.M.

Fitzpatrick_COBUmap.cdr