



Claim of Beneficial Use
Permit G-16001 Application G-16281

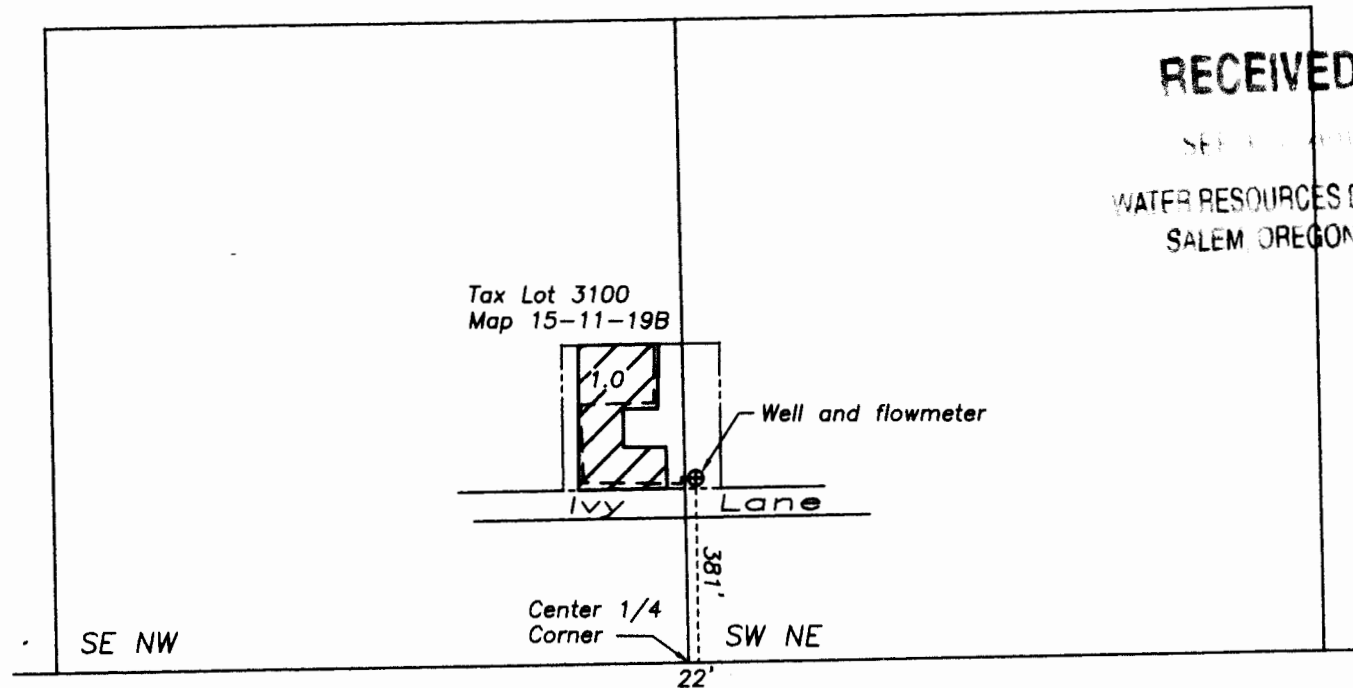


Section 19
T15S, R11E, W.M.
Deschutes Co., Oregon

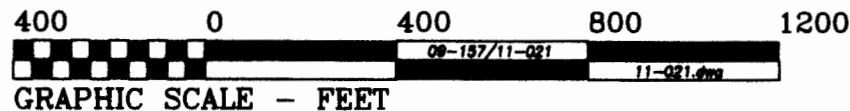

RECEIVED

WATER RESOURCES DEPT
SALEM, OREGON

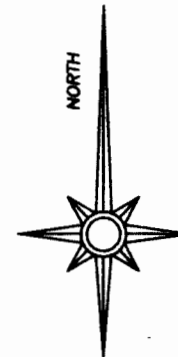

9/1/2011




Renewal date: 6/30/2012



Extent of beneficial use under
Permit G-16001, priority date
7/23/2004



Tax lot boundary

 

Mainline



Well and meter



1/16 Section lines

THIS MAP IS FOR THE PURPOSE OF IDENTIFYING THE LOCATION OF THE
WATER RIGHT. IT IS NOT INTENDED TO PROVIDE LEGAL DIMENSIONS OR
LOCATIONS OF PROPERTY OWNERSHIP LINES.