


Township 6 South, Range 1 West, W.M.

Portions of Sections 20, 21, 28 & 29

RECEIVED


JUL 3 1995

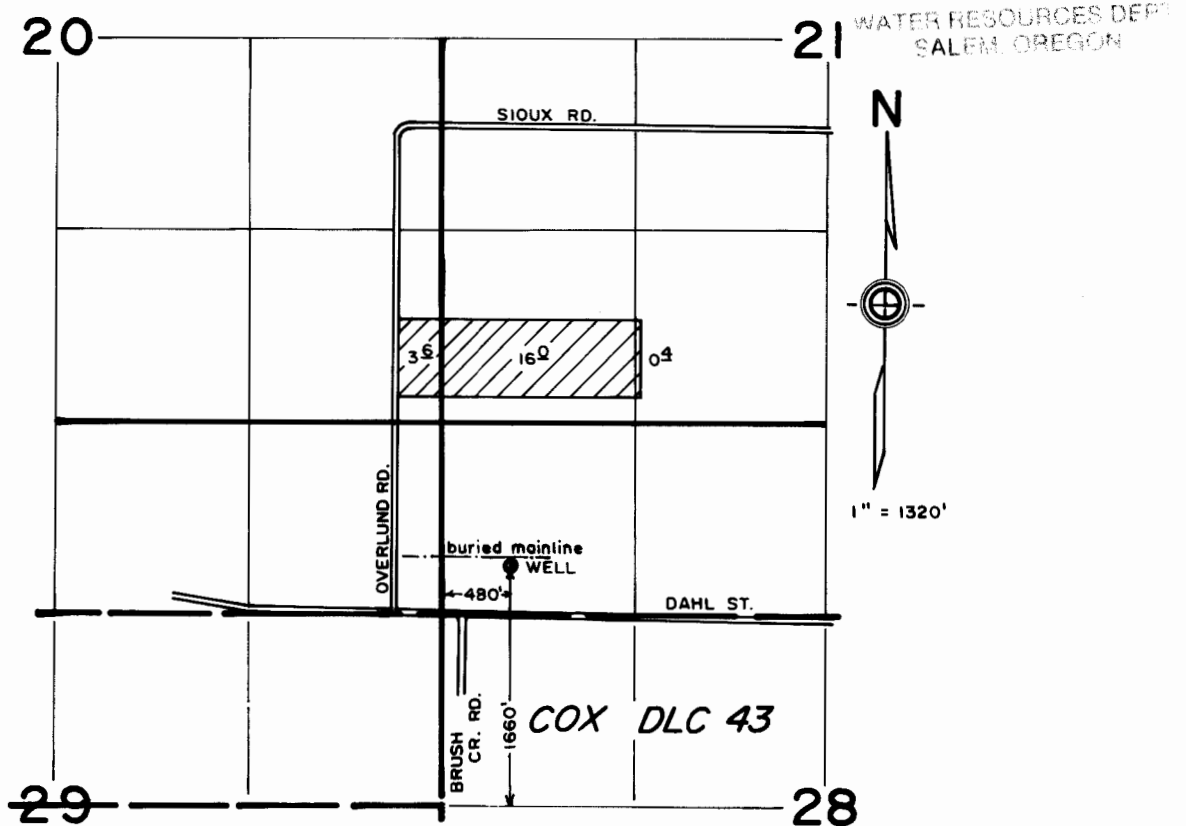

FINAL PROOF SURVEY
under
Appl. No. G-13621, Per. No. G-11947
in name of

ALLEN ZITZELBERGER

June 26, 1995

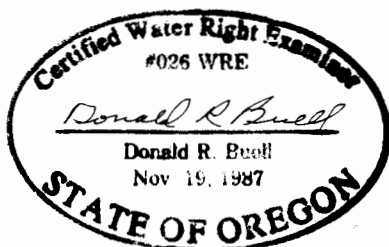

THIS MAP WAS PREPARED FOR THE PURPOSE OF IDENTIFYING THE LOCATION OF A WATER RIGHT ONLY AND IS NOT INTENDED TO PROVIDE LEGAL DIMENSIONS OR LOCATION OF PROPERTY OWNERSHIP LINES.