


CLAIM OF BENEFICIAL USE
 FOR: MARCIA C. RODINE
 BY: DUANE W. KIRBY
 T31S, R3W, W.M., SEC 32
 TAX LOT 301
 DATE: JUNE 27, 2006
 APPLICATION NO T-9470

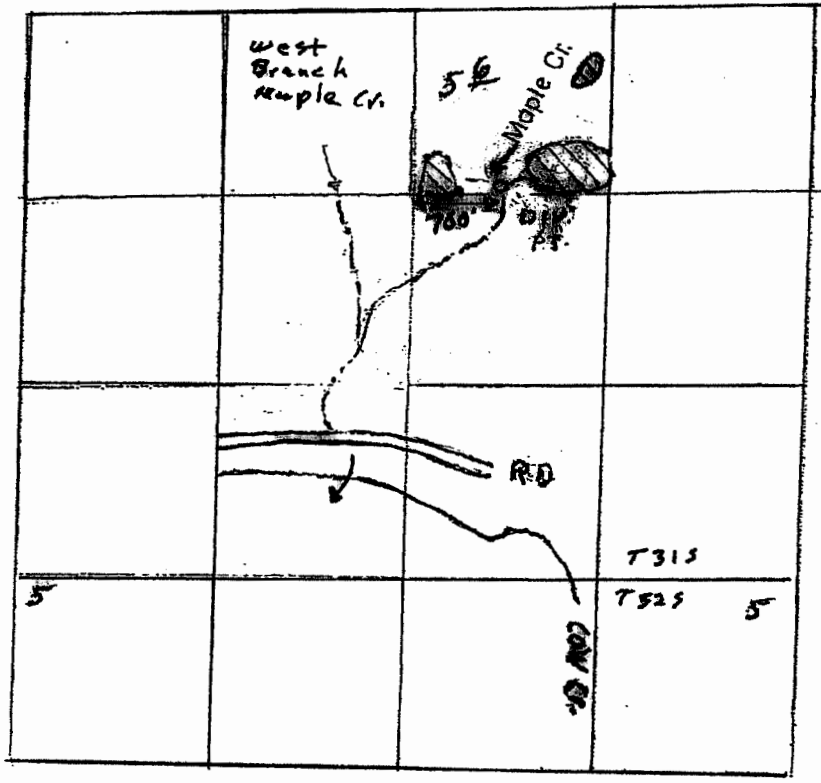

SCALE: 1" = 1320'



RECEIVED BY OWRD

SEP 29 2016

SALEM, OR

Point of Diversion: SW NE | 700 ft. E. from the Center of Section 32

MAPLE CR



THE PURPOSE OF THIS MAP IS TO IDENTIFY THE LOCATION OF THE WATER RIGHT. IT IS NOT INTENDED TO PROVIDE INFORMATION RELATIVE TO THE LOCATION OF PROPERTY OWNERSHIP BOUNDARY LINES.