

# FINAL PROOF MAP IN THE NAME OF BRIAN & DEE MOORE




RECEIVED

APR 19 2012

WATER RESOURCES DEPT  
PORTLAND, OREGON


## T-10683

### T 1 N R 3 W, W.M. Section 35

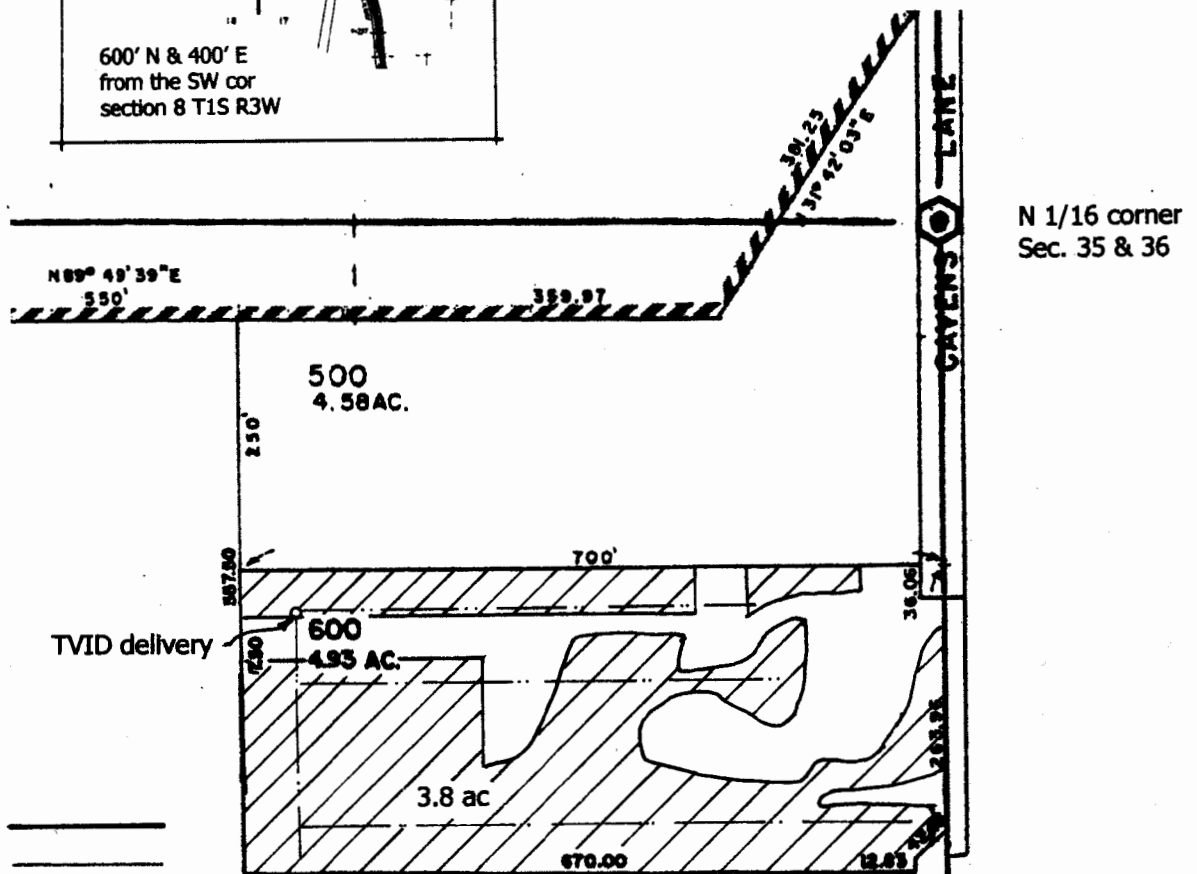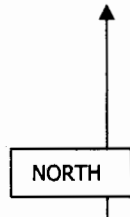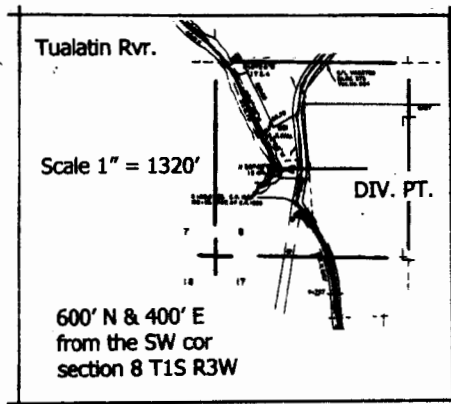

Section line —————  
Quarter line —————  
Pipe line - - - - -

Scale 1" = 200'

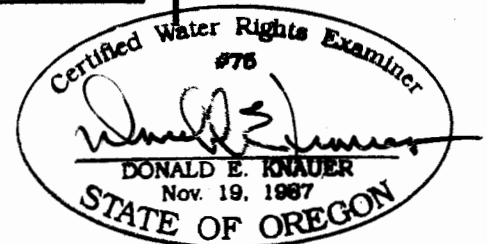

This map is not intended to provide legal  
dimensions or locations of property ownership lines.

RENEWAL DATE: 6-30-2013