


T22S, R29E, W.M.
Harney County, Oregon

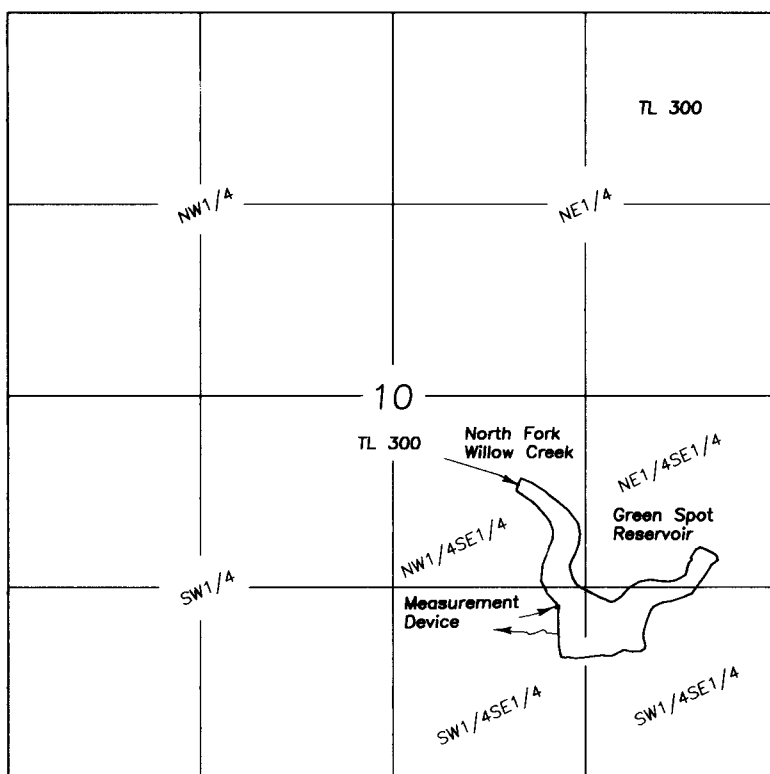

SCALE 1"=1320'

Outlet is located 1200' North & 1510' West of the
SE corner of Section 10.

Measuring device is located 65' South and 18' East of the Outlet

FINAL PROOF SURVEY
CLAIM OF BENEFICIAL USE
GREEN SPOT RESERVOIR

LEGEND

Application No. R-33796
Permit No. R-2397
Priority 3/25/1960

A portion of Tax Lot
22-29 TL 300

NOTE: Tax Lot 300 is owned by the BLM
and is more that 12,000 acres.
No tax lot boundaries can be shown.

For

Bureau of Land Management

August 31, 2016

Prepared by

Cornerstone Surveying, Inc

P.O. BOX 33

JOHN DAY, OR. 97845

(541)575-1813

cornerstonesurvey@centurytel.net

NOTE: The preparation of this map
was for the purpose of identifying
the location of the proposed water
right and has no intent to provide
dimensions or location of property
ownership lines.

RECEIVED BY BUREAU

2016

10/16/16

