


T. 11 S. R. 19 E

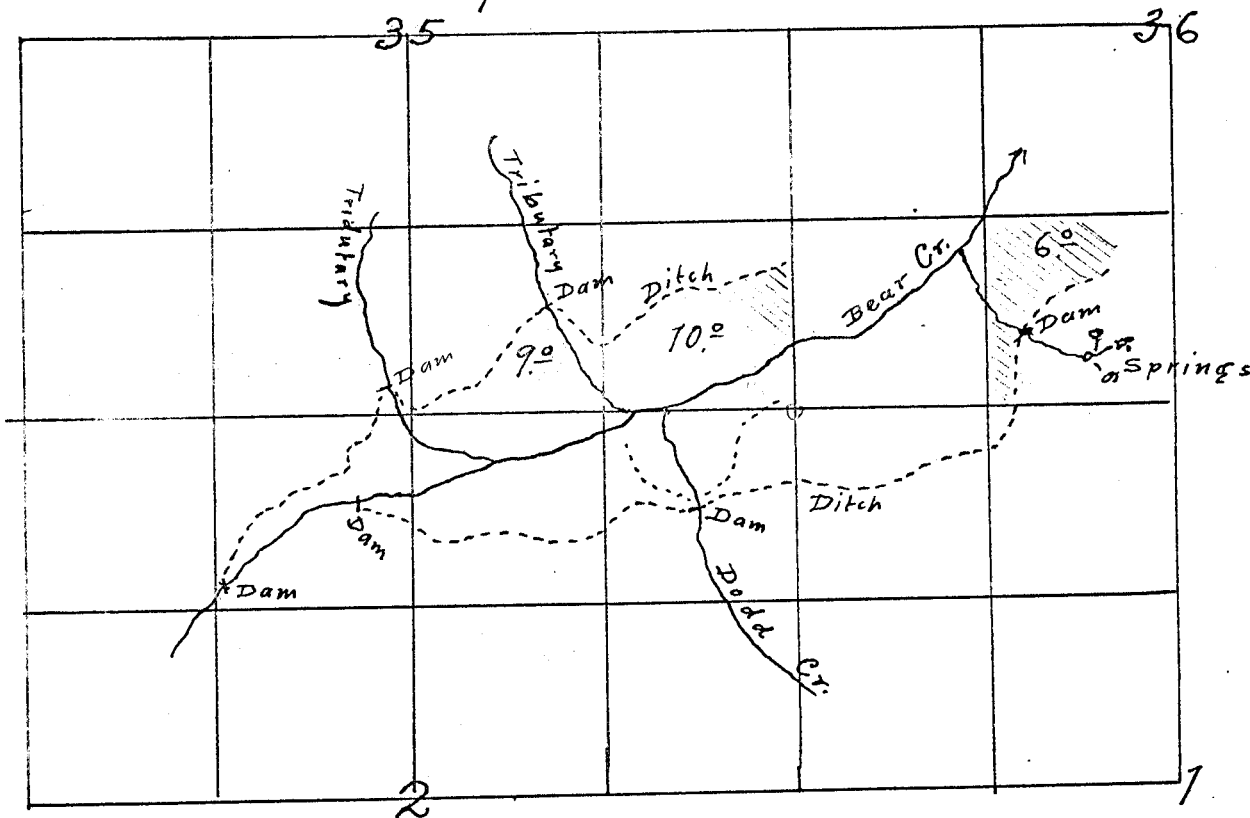

T. 12 S. R. 19 E.

To accompany application of M.H. Stoneman

Application No. 11524  
Permit No. 7959