

Supplement to Application 2000001

WATER RIGHT TRANSFER APPLICATION MAP

SHOWING A CHANGE IN POINT OF DIVERSION AND IN PLACE OF USE

T.36 S. R.06 W. W.M.

AFFECTING PORTIONS OF:

PERMIT No. 1290 CERT. No. 1953 &

PERMIT No. 9692 CERT. No. 8942

T - _____
 APPLICANT:


DUTCHER CREEK ENTERPRISES, INC.
 4611 UPPER RIVER ROAD
 GRANTS PASS, OREGON 97526
 Ph. (541) 474-2188

THIS MAP IS FOR THE PURPOSE OF IDENTIFYING THE LOCATION OF THE WATER RIGHT ONLY, AND IS NOT INTENDED TO PROVIDE LEGAL DIMENSIONS OR LOCATIONS OF PROPERTY OWNERSHIP LINES.

LEGEND:

-  AREA TO WHICH WATER RIGHTS ARE TO BE TRANSFERRED
-  AREA FROM WHICH WATER RIGHTS ARE TO BE TRANSFERRED
-  IRRIGATED UNDER PERMIT 1290 CERT. 1953
-  IRRIGATED UNDER PERMIT 9692 CERT. 8942

MAP SHOWING POINTS OF DIVERSION
 SCALE: 1" = 2640'

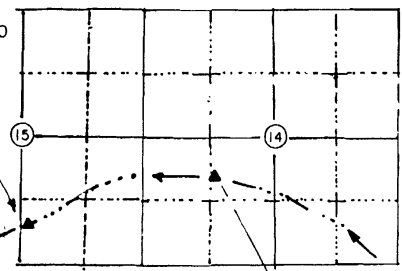

RECEIVED
JUL 28 2015
OWRD

S 61' E, 1580' FROM 1/4 CORNER SEC. 14 & 15

PROPOSED (HISTORIC) POINT OF DIVERSION
 PERMIT 1290, CERT. 1953
 CURRENT POINT OF DIVERSION
 PERMIT 9692 CERT. 8942
 FT. VANNOY IRRIGATION DISTRICT.


Jonathan C. Spero
 Jonathan C. Spero
 Nov. 19, 1987
 STATE OF OREGON

LICENSE RENEWAL DATE:
 JUNE 30, 2002

PREPARED BY:
JONATHAN C. SPERO C.W.R.E. 123
 1002 KINCAID RD./P.O. BOX 16
 WILLIAMS, OREGON 97544
 PH. (541) 846-6845

REVISED: NOVEMBER 20, 2000

FEBRUARY 28, 2000

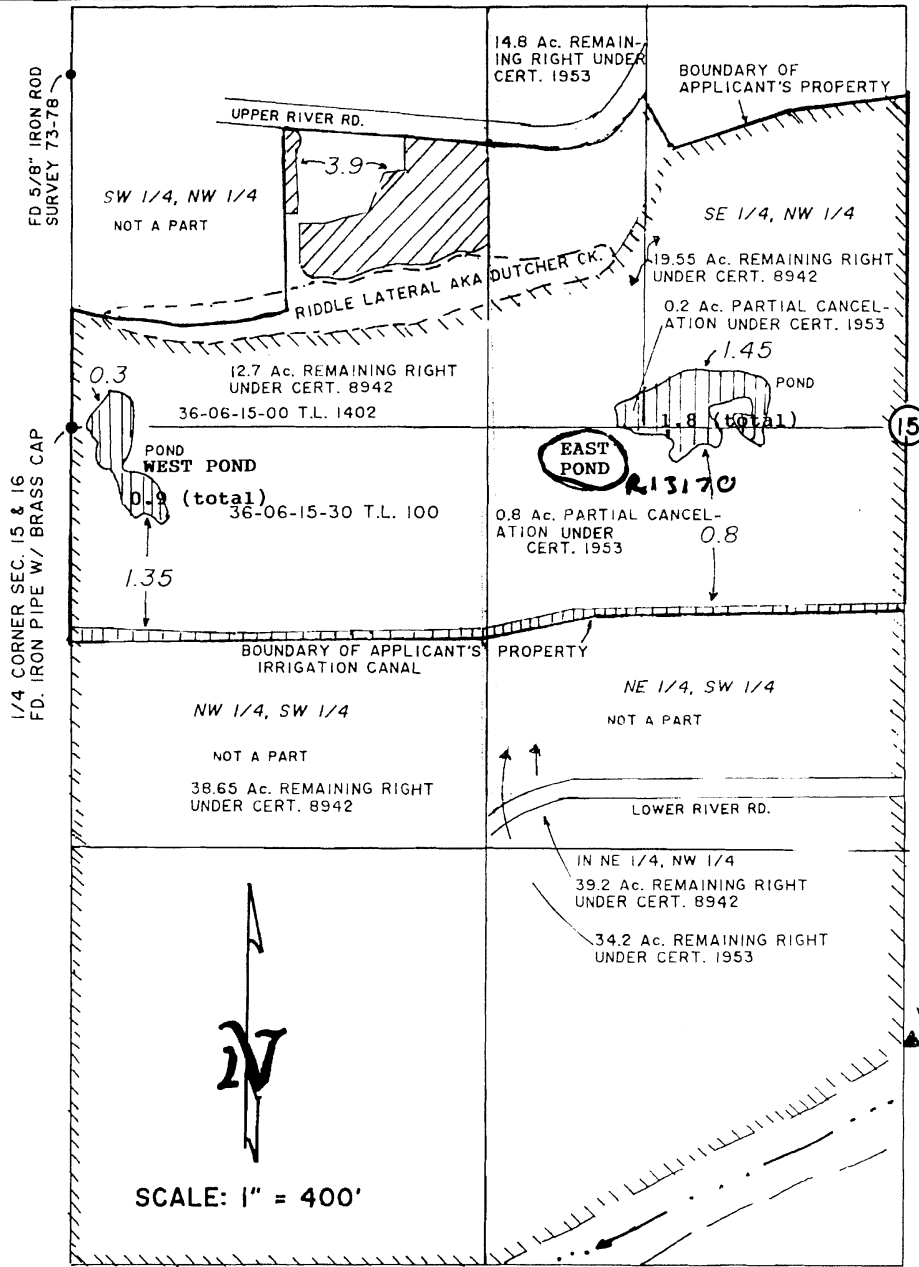

SCALE: 1" = 400'