

Submitted for Application R-34607

# WATER RIGHT TRANSFER APPLICATION MAP SHOWING A CHANGE IN POINT OF DIVERSION AND IN PLACE OF USE

## T.36 S. R.06 W. W.M.

AFFECTING PORTIONS OF:

PERMIT No. 1290 CERT. No. 1953 & T - \_\_\_\_\_

PERMIT No. 9692 CERT. No. 8942

APPLICANT:


**DUTCHER CREEK ENTERPRISES, INC.**  
4611 UPPER RIVER ROAD  
GRANTS PASS, OREGON 97526  
Ph. (541) 474-2188

THIS MAP IS FOR THE PURPOSE OF IDENTIFYING THE LOCATION OF THE WATER RIGHT ONLY, AND IS NOT INTENDED TO PROVIDE LEGAL DIMENSIONS OR LOCATIONS OF PROPERTY OWNERSHIP LINES.

### LEGEND:

-  AREA TO WHICH WATER RIGHTS ARE TO BE TRANSFERRED
-  AREA FROM WHICH WATER RIGHTS ARE TO BE TRANSFERRED
-  IRRIGATED UNDER PERMIT 1290 CERT. 1953
-  IRRIGATED UNDER PERMIT 9692 CERT. 8942


MAP SHOWING POINTS OF DIVERSION  
SCALE: 1" = 2640'

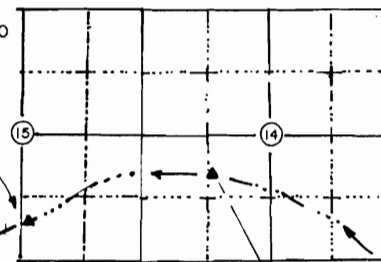

RECORD POINT OF DIVERSION  
PERMIT 1290, CERT. 1953  
29.26 CHAINS SOUTH OF  
THE CENTER OF SECTION 15

ROGUE RIVER

S 61° E, 1580' FROM 1/4  
CORNER SEC. 14 & 15  
PROPOSED (HISTORIC)  
POINT OF DIVERSION  
PERMIT 1290, CERT. 1953  
CURRENT POINT OF DIVERSION  
PERMIT 9692 CERT. 8942  
FT. VANNOY IRRIGATION DISTRICT.

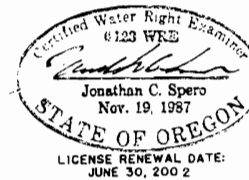

PREPARED BY:  
**JONATHAN C. SPERO C.W.R.E. 123**  
1002 KINCAID RD./P.O. BOX 16  
WILLIAMS, OREGON 97544  
PH. (541) 846-6845

REVISED: NOVEMBER 20, 2000

FEBRUARY 28, 2000

**RECEIVED**  
JUL 28 2015  
OWRD

SCALE: 1" = 400'

