


# T1N., R2W., W.M.

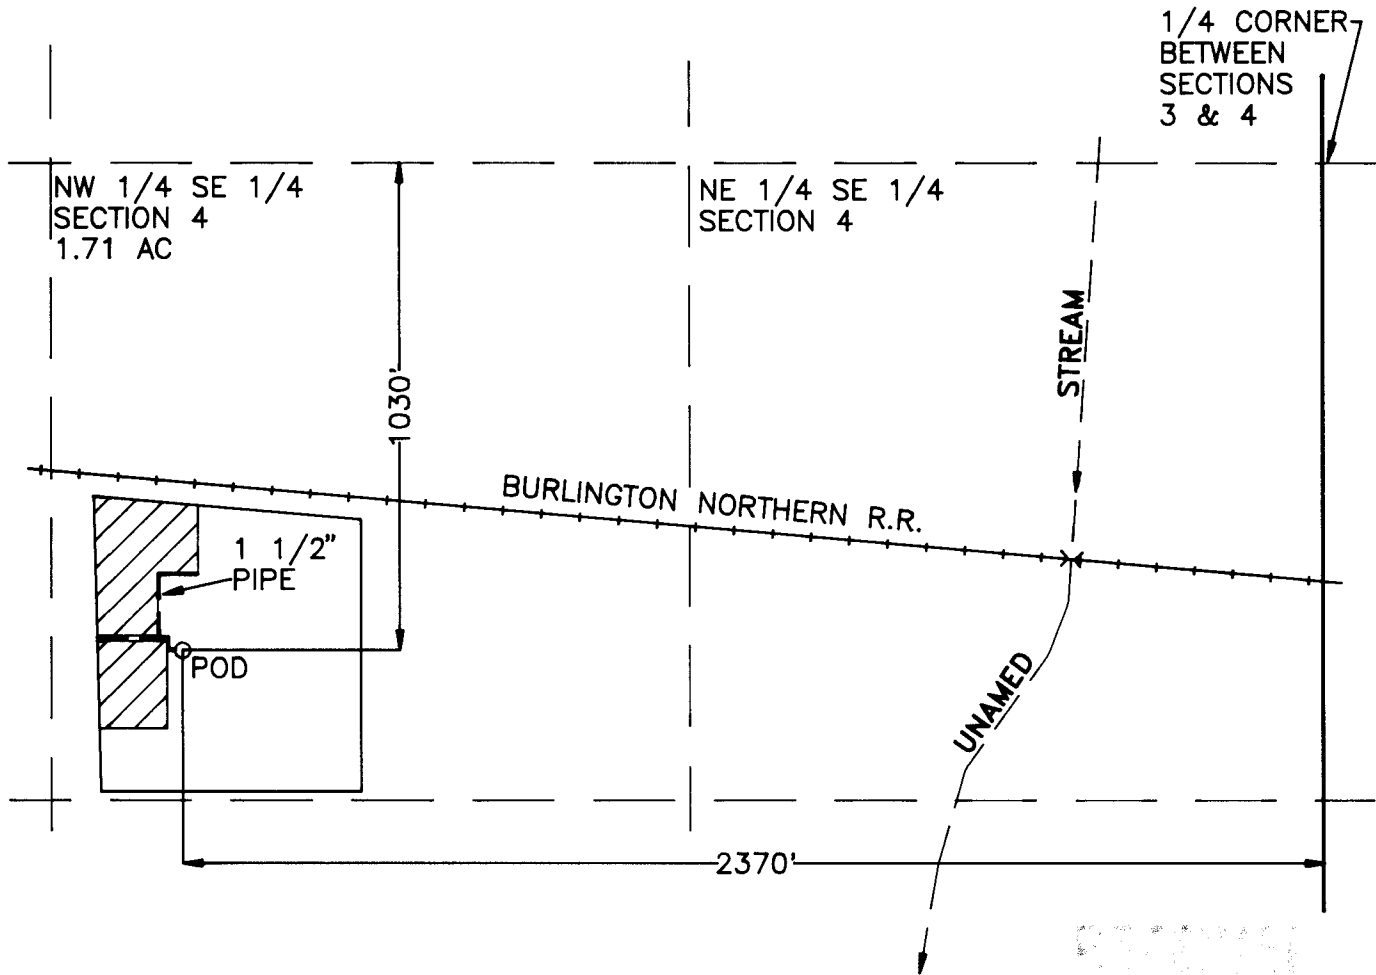

## FINAL PROOF SURVEY

UNDER

Application No. G-12202 Permit No. G-11344


IN NAME OF

BRUCE AND KARLA CALLAGHAN

Surveyed SEPTEMBER 13, 1993, by DAN KEPPEM



SCALE: 1" = 400'

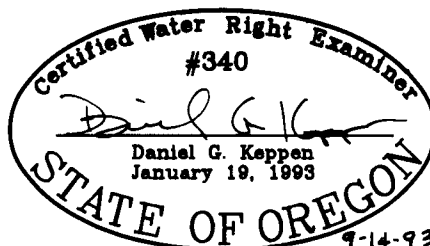

EXPIRES 12\31\93

THIS MAP IS FOR THE PURPOSE OF IDENTIFYING THE LOCATION OF THE WATER RIGHT ONLY AND IS NOT INTENDED TO PROVIDE LEGAL DIMENSIONS OR THE LOCATION OF PROPERTY OWNERSHIP LINES.