


# Claim of Beneficial Use Map

**Transfer T-7837, Permit S-5996 and S-7400**  
**Water Right in the Name of Steven McCambridge and Nina McCambridge**  
**Township 2 North, Range 32 East (W.M.)**

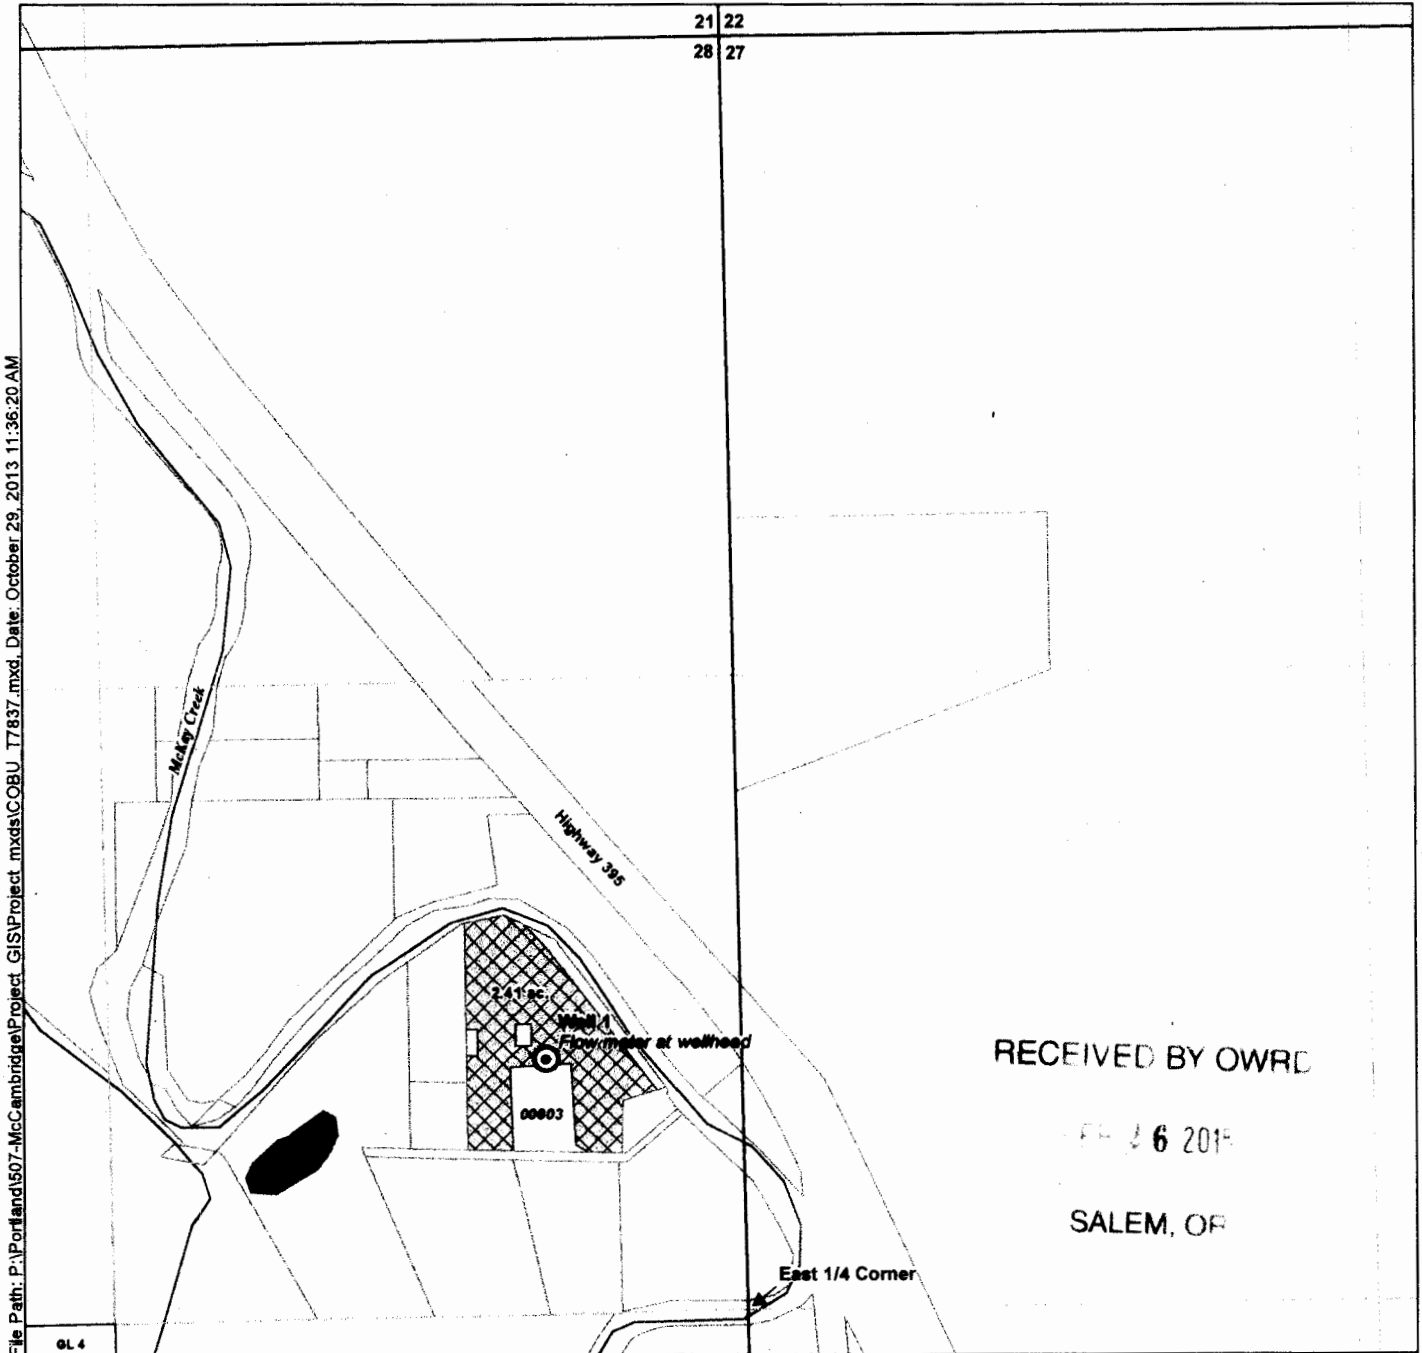

File Path: P:\Portland\507-McCambridge\Project\_GIS\Project\_mxd\COBU\_T7837.mxd, Date: October 29, 2013 11:36:20 AM


**LEGEND**

- Point of Diversion (POD)
- Primary Irrigation (Umatilla River)  
8/16/1923 Priority
- Supplemental Irrigation (McKay Reservoir)  
7/1/1924 Priority
- Government Lot
- Tax Lot
- Watercourse
- Waterbody

**POD Location Description**

**Point of Diversion**  
 Located 540 feet North and 410 feet West from the East quarter corner of Section 28, Township 2 North, Range 32 East (W.M.)

**Certified Water Rights Examiner Stamp**

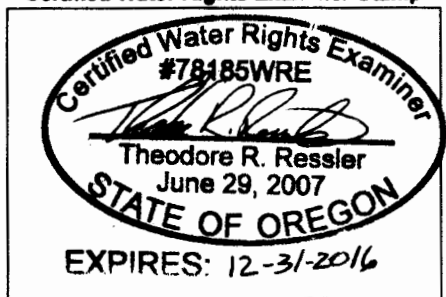

RECEIVED BY OWRC  
 FEB 26 2015  
 SALEM, OR

**Disclaimer**

This map was prepared for the purpose of identifying the location of a water right only and it is not intended to provide legal dimensions or location of property ownership lines.

**Map Notes**

Date: November 14, 2013  
 Data Sources: BLM, ESRI, USGS  
 Prepared By: GSI Water Solutions, Inc.

