


Claim of Beneficial Use Map


Transfer T-7837, Permit S-5996 and S-7400
Water Right in the Name of Steven McCambridge and Nina McCambridge
Township 2 North, Range 32 East (W.M.)

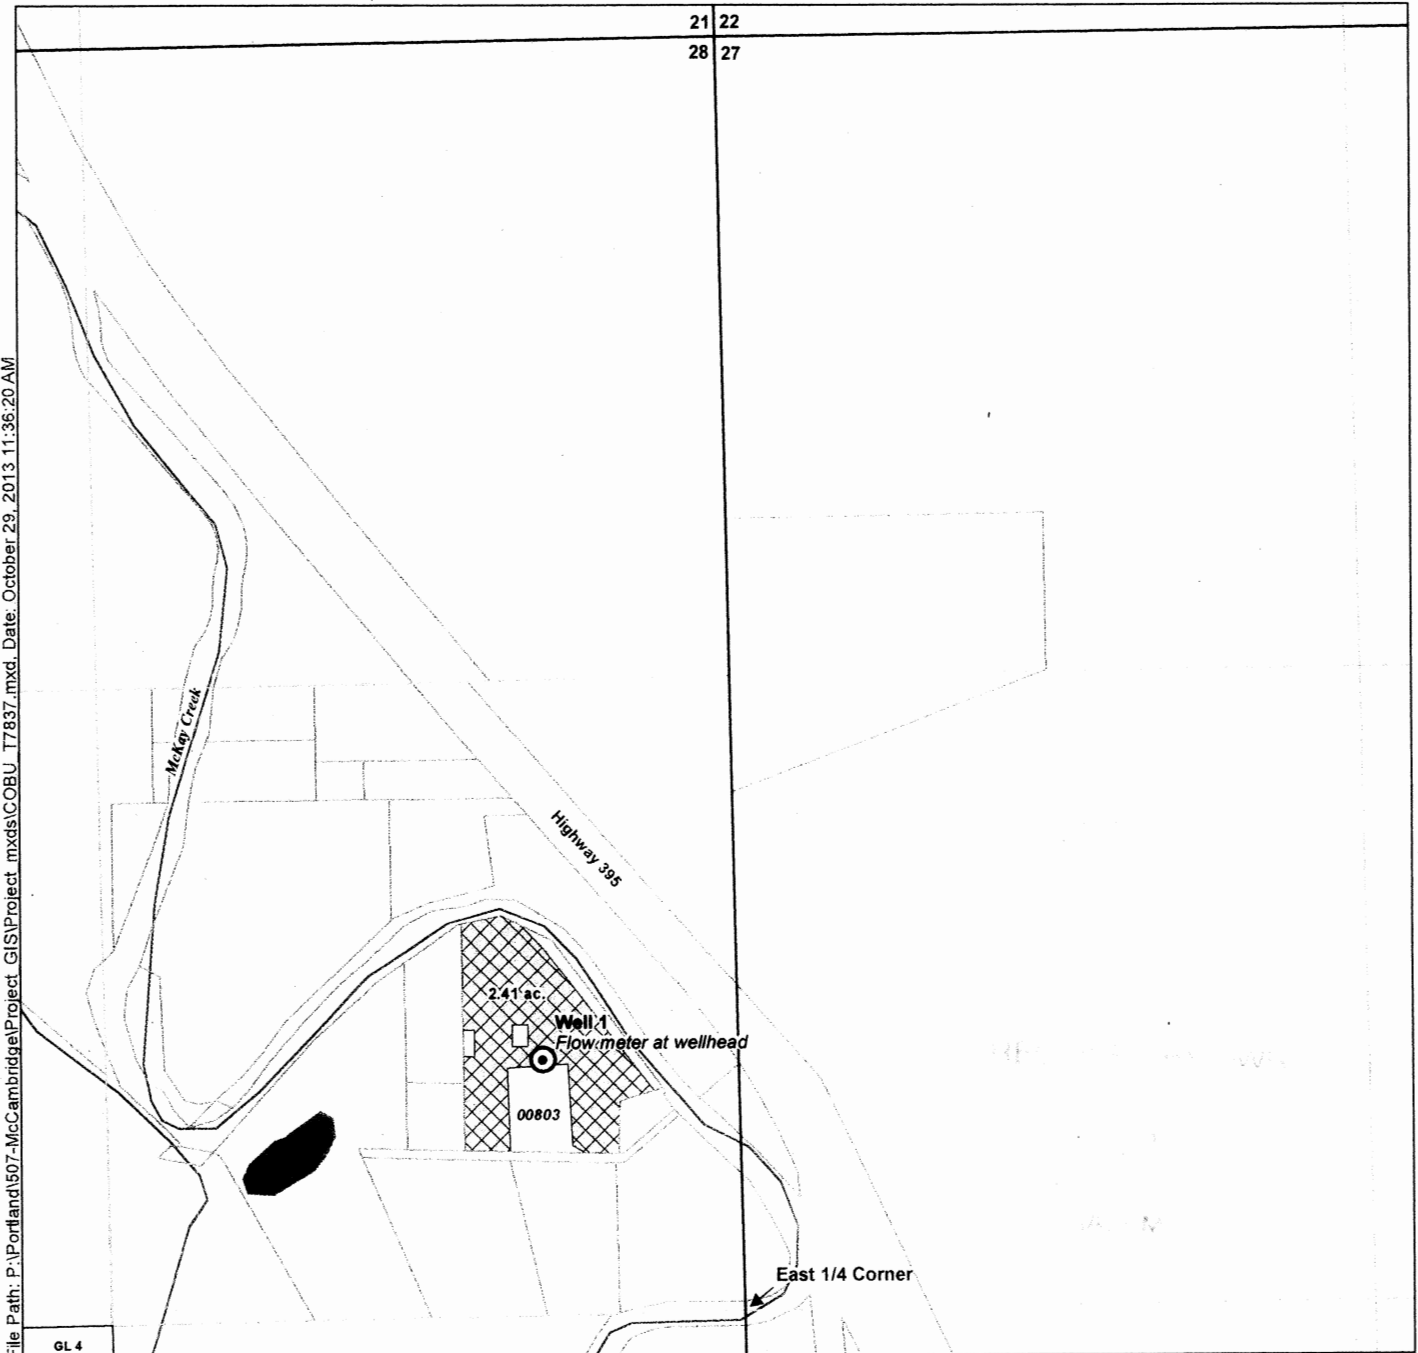

File Path: P:\Portland\507-McCambridge\Project_GIS\Project_mxd\COBU_T7837.mxd, Date: October 29, 2013 11:36:20 AM

- LEGEND**
- Point of Diversion (POD)
 - Primary Irrigation (Umatilla River)
8/16/1923 Priority
 - Supplemental Irrigation (McKay Reservoir)
7/1/1924 Priority
 - Government Lot
 - Tax Lot
 - Watercourse
 - Waterbody

POD Location Description
Point of Diversion
 Located 540 feet North and 410 feet West from the East quarter corner of Section 28, Township 2 North, Range 32 East (W.M.)

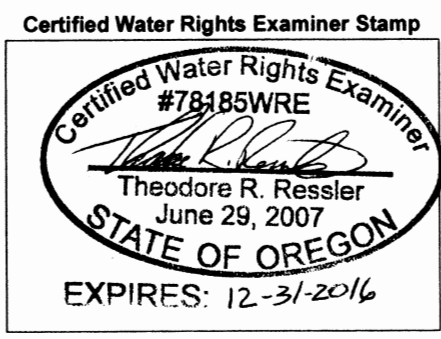

Disclaimer
 This map was prepared for the purpose of identifying the location of a water right only and it is not intended to provide legal dimensions or location of property ownership lines.

Map Notes
 Date: November 14, 2013
 Data Sources: BLM, ESRI, USGS
 Prepared By: GSI Water Solutions, Inc.

