


Township 6 South, Range 1 West, W.M.

Portions of Sections 31 and 32

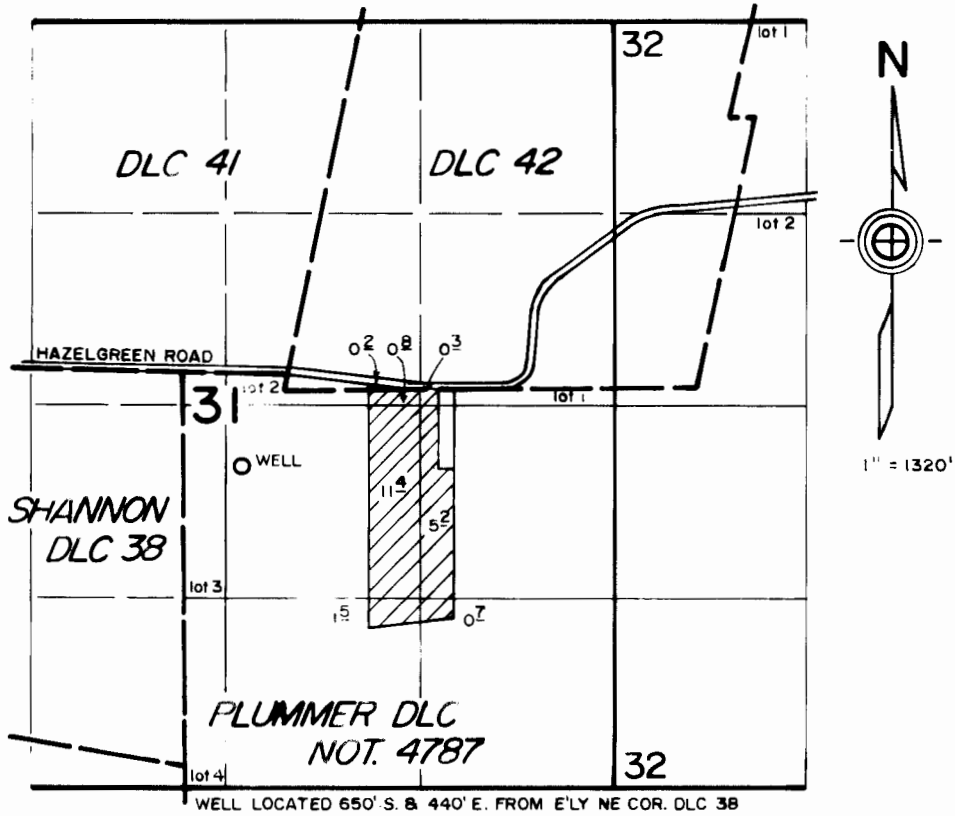

FINAL PROOF SURVEY

under

Appl. No. G-12709, Per. No. G-11656

in name of


COOLEY'S GARDENS

Jan. 27, 1997

RECEIVED

FEB 3 1997

WATER RESOURCES DEPT
SALEM, OREGON

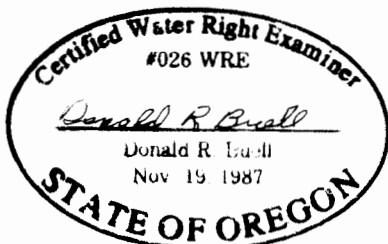

THIS MAP WAS PREPARED FOR THE PURPOSE OF IDENTIFYING THE LOCATION OF A WATER RIGHT ONLY AND IS NOT INTENDED TO PROVIDE LEGAL DIMENSIONS OR LOCATION OF PROPERTY OWNERSHIP LINES.