


SECTION 25, TWP. 11 S. RANGE 20 E. W.M. WHEELER COUNTY, OREGON

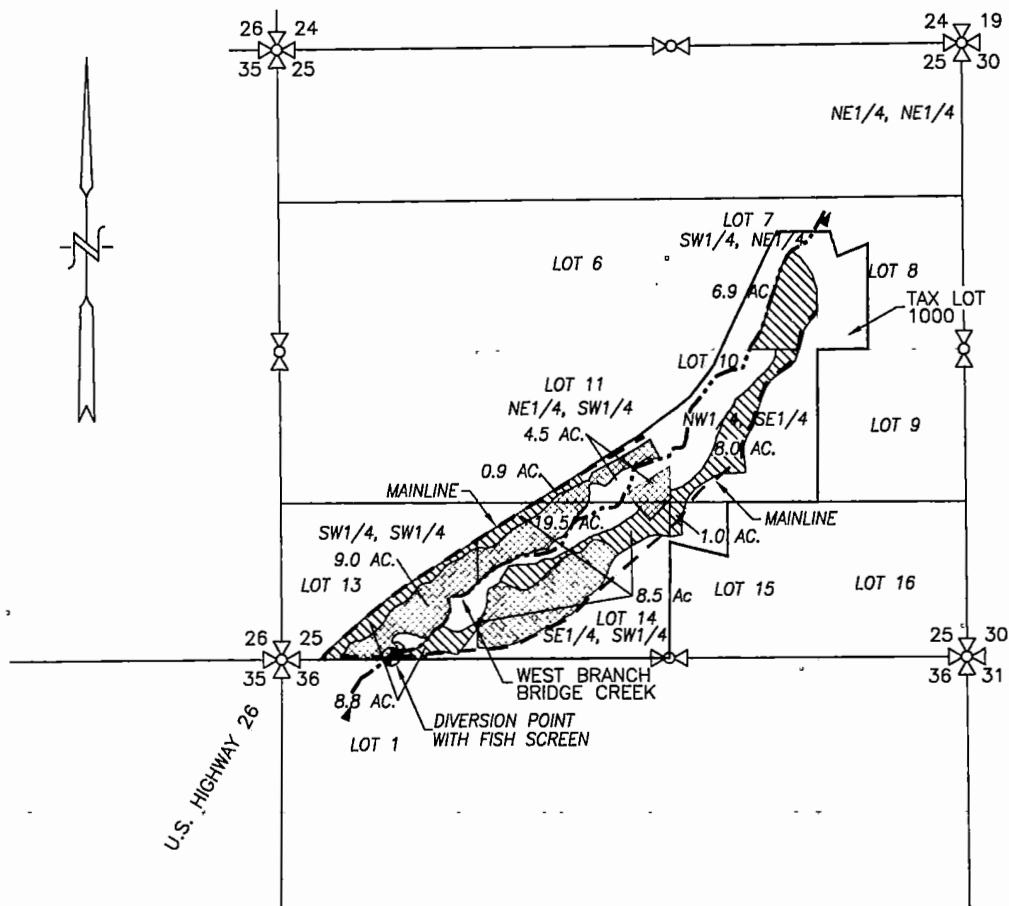

PLACE OF USE FROM O.W.R.D. FINAL PROOF SURVEY MAP BY
J. MILLER FOR APPLICATION 64480 ON MARCH 5, 1992.

LEGEND :

- DIVERSION POINT: 20' NORTH & 950' EAST OF SW COR. SEC. 25
- OLD CERTIFICATE 82387 (34.1 AC.)
- OLD CERTIFICATE 81649 (33.0 AC.)
- IRRIGATION MAIN
- STREAM WITH DIRECTIONAL FLOW


RECEIVED BY OWRD

OCT 04 2012

SALEM, OR

CLAIM OF BENEFICIAL USE MAP

SCALE: 1"= 1320'

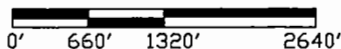

TRANSFER No. 9891

IN THE NAME OF:

JOYCE BROOKS

DATE: SEPTEMBER 17, 2012



EXPIRES: 06/30/2014

BY: **TENNESON ENGINEERING CORP.**

3313 W. 2ND. STREET, SUITE 100
THE DALLES, OREGON. 97058
PH. 541-296-9177
FAX 541-296-6657



NOTE:


"THIS MAP IS NOT INTENDED TO
PROVIDE DIMENSIONS OR LOCATIONS
OF PROPERTY OWNERSHIP LINES."

W.O. #13849wr

T. 11 S., R. 20 E., W.M.

-  PRIM. UN. DRAW POD #1
SUPP. W. BR. BRIDGE CR. POD # 3.
-  LAND IRR. FR. POD # 2
DITCH NORTH SIDE
-  LAND IRR. FR. POD # 2
DITCH SOUTH SIDE
-  LAND IRR. FR. POD # 3
-  LAND IRR. FR. POD # 2
DITCH SOUTH SIDE, &/or POD # 3.
-  LAND IRR. FR. POD # 4.

1" = 1320'

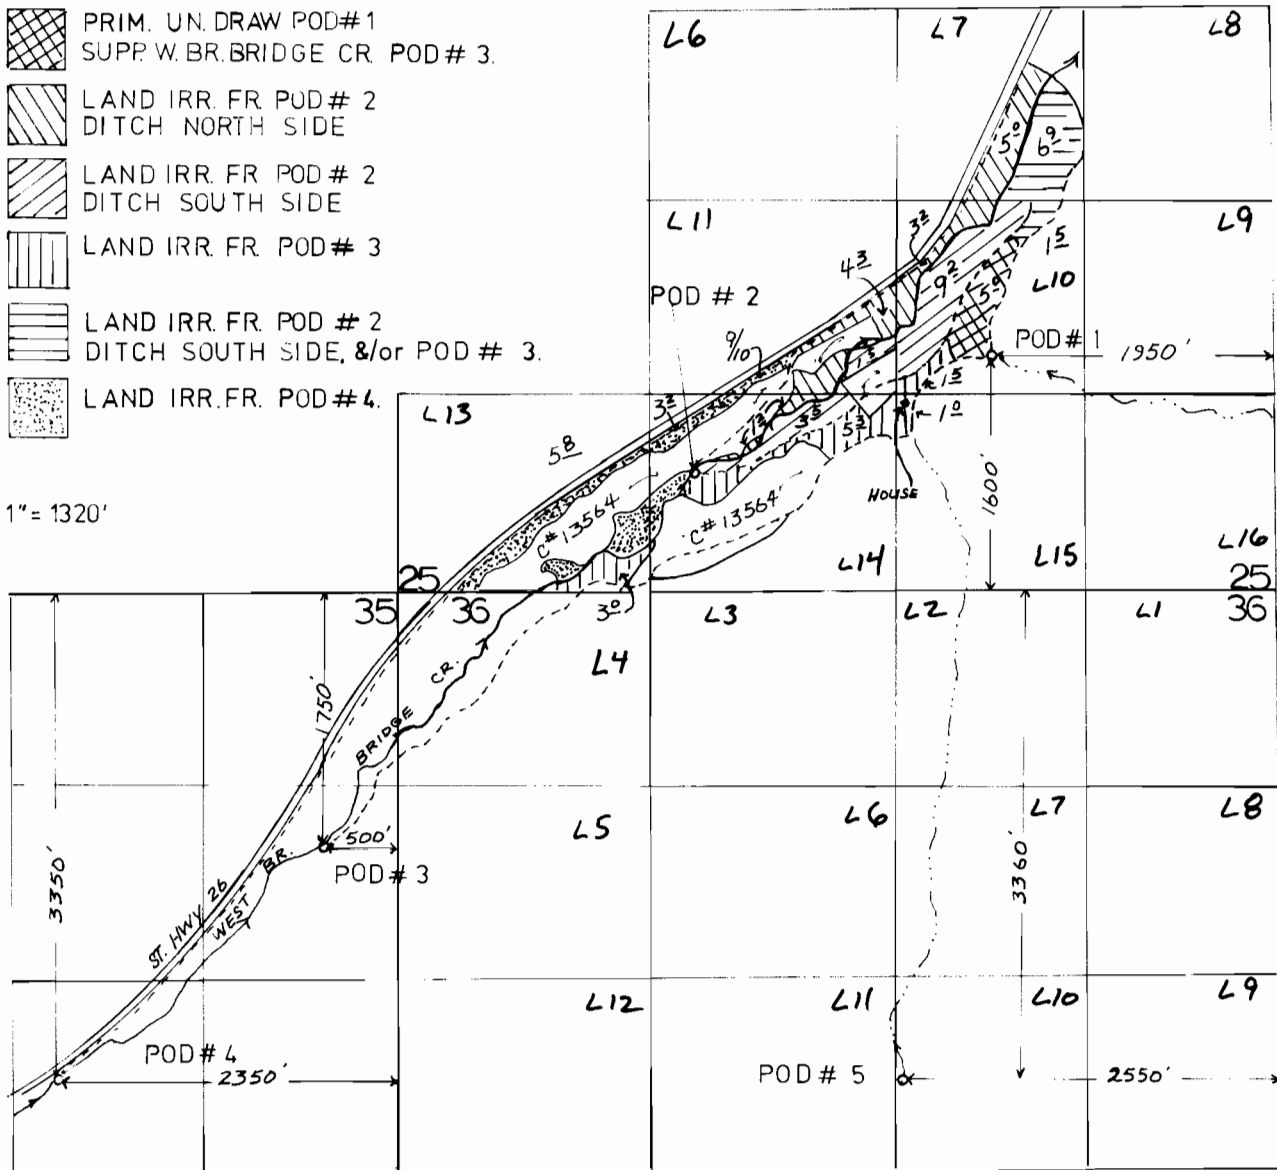

POD # 2 - 800' NORTH AND 2030' EAST FROM SOUTHWEST CORNER SECTION 25.

FINAL PROOF SURVEY

UNDER

Application No. 64480 Permit No. 47328
IN NAME OF

JAMES AND JOYCE BROOKS

Surveyed 3-5, 1992, by J. MILLER

