

LEGEND

POINT OF USE

LAND STATUS S = STATE
B = BLM

PIPELINE

SECTION CORNER +

MARY ANN PIPELINE
SCALE 1:24,000
4/11/88 MAJORS
Phayors

Application No. 68940
Permit No. 50730

28
Cooper
Reservoir
(Proposed)
(Later Date)

Cooper Draw
33

spring
development
Big Rock
Reservoir

Mary Ann Draw

All corrections and changes
made 4/11/88 *Phayors*

R23E R24E

RECEIVED

APR 21 1988

WATER RESOURCES DEPT.
SALEM, OREGON


T 34 S
T 35 S

RECEIVED

Period No. 50730

8/20/86 C.M. Jones

1969 II SE
(COOPER DRAW)

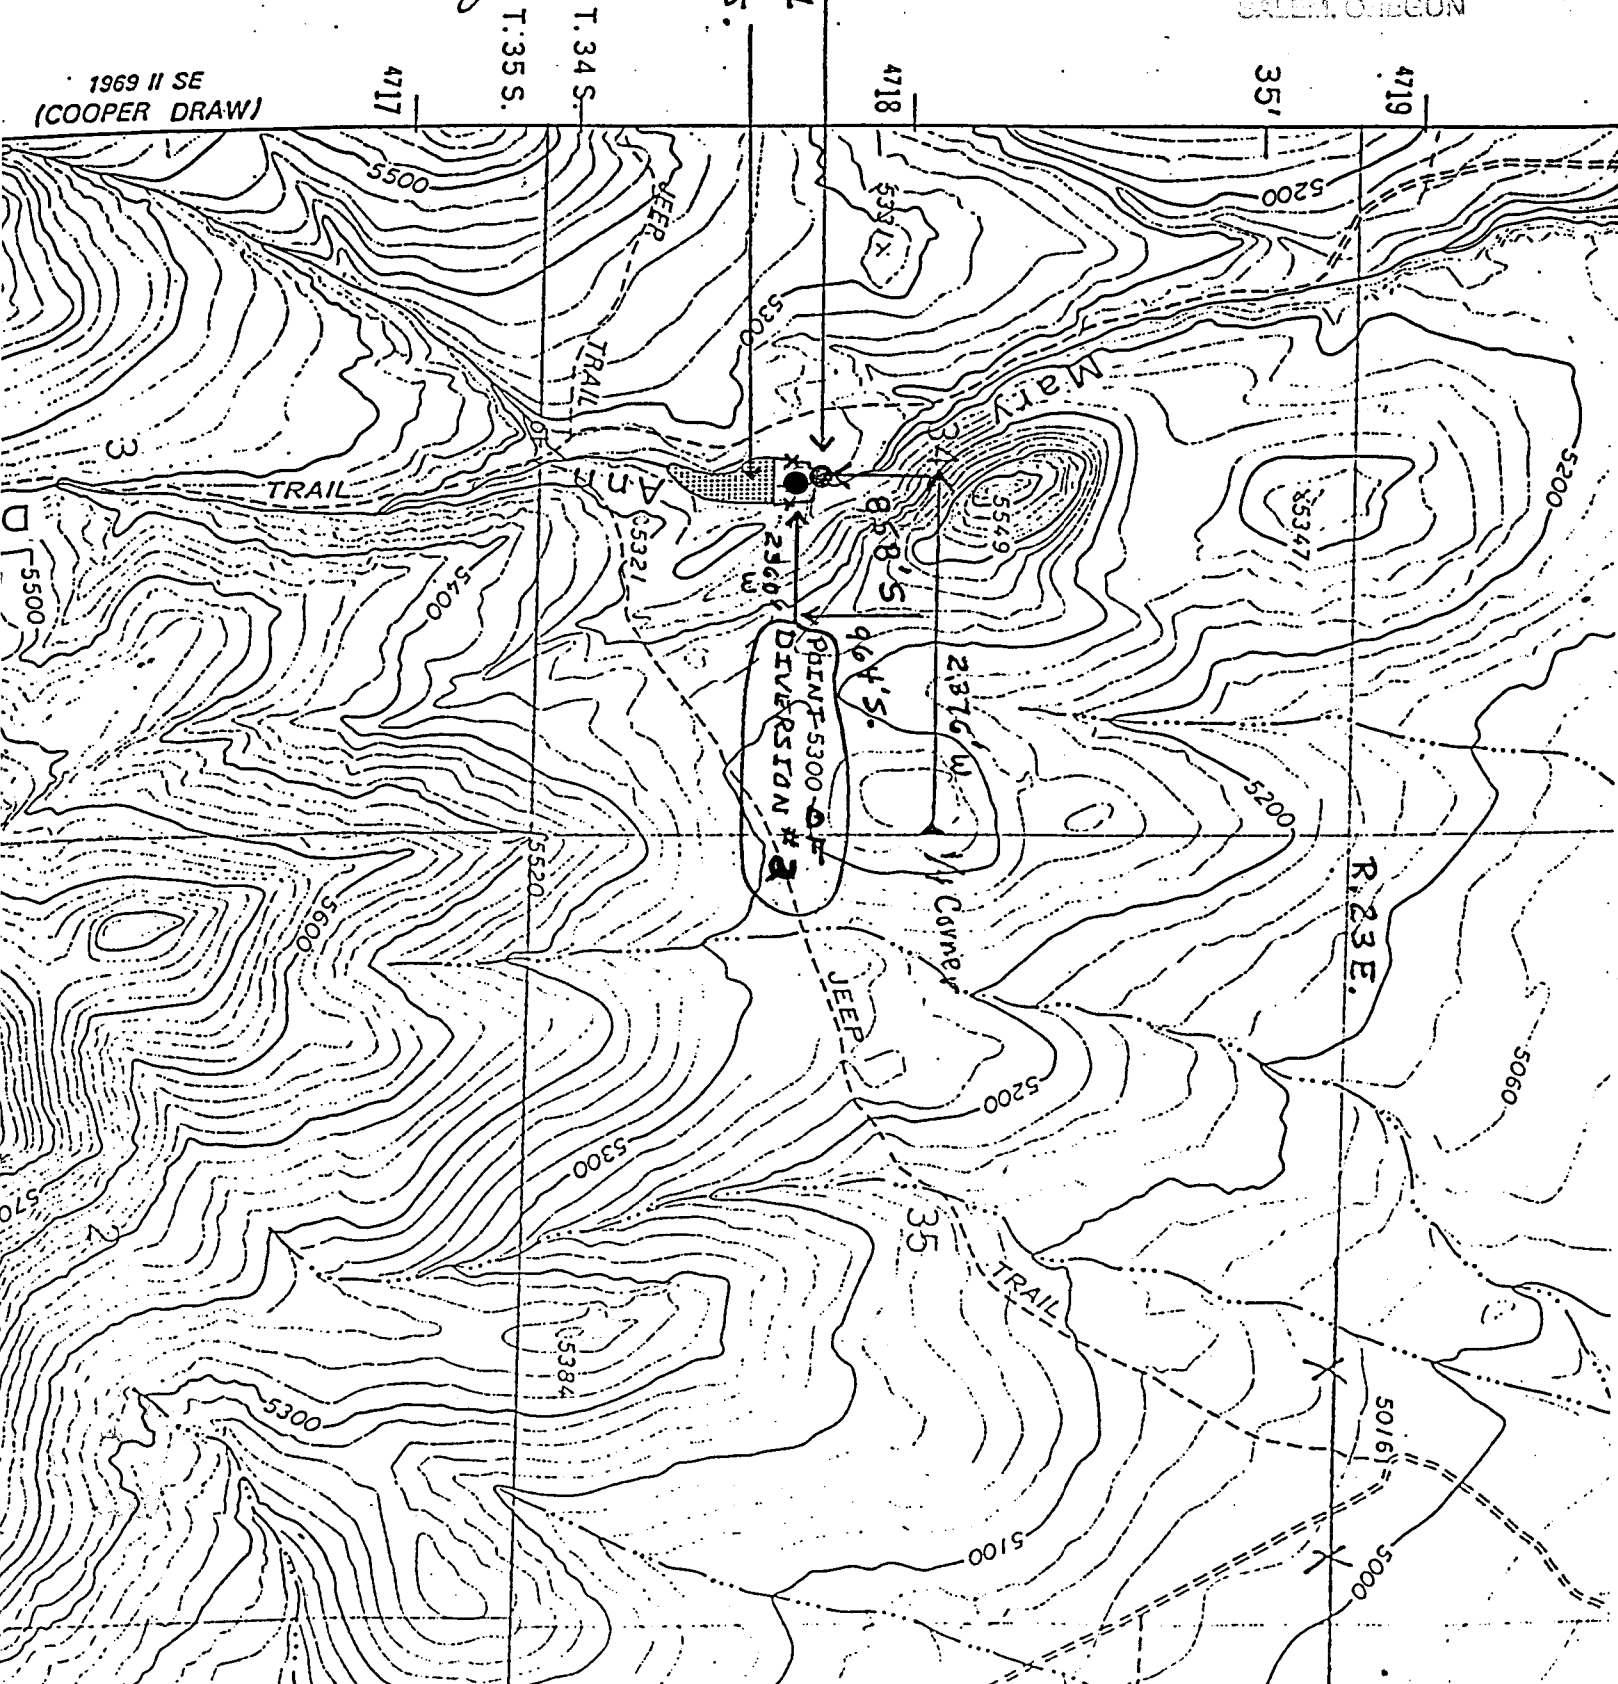

R.23E.

STATE LAND

☐ PUBLIC LAND

PIPELINE

AROGA
SEEDING
505 ac

proposed to
extend further

8/86. Phayre

MARK ANN
PROPOSED PIPELINE