


# T. 27 S. R. 13 W.W.M.

## SECTION 2

THIS MAP IS FOR THE PURPOSE OF LOCATING THE WATER RIGHT ONLY AND IS NOT INTENDED TO PROVIDE LEGAL DIMENSIONS OR LOCATIONS OF PROPERTY OWNERSHIP LINES

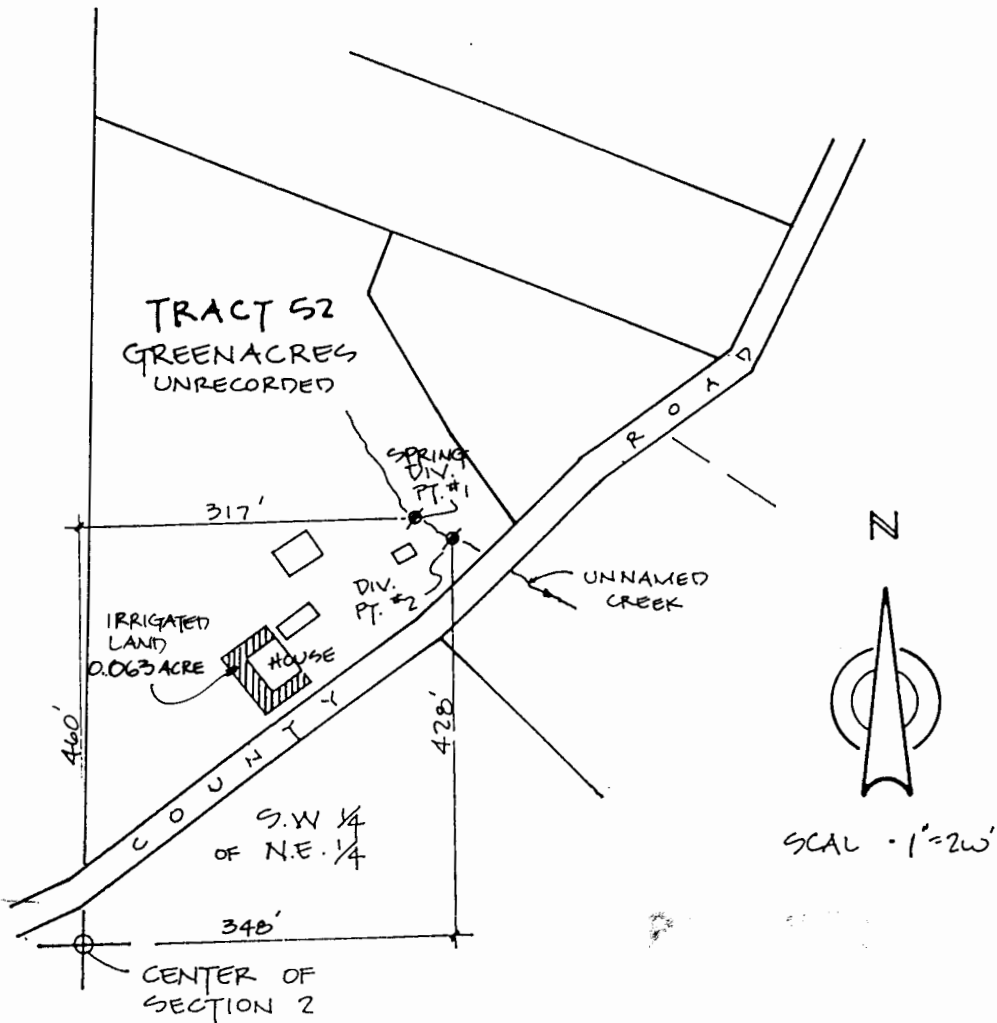

### FINAL PROOF SURVEY UNDER

Application No. 69455 Permit No. 50376  
IN NAME OF

FRANK I. & MAXINE McFARLANE

Surveyed 7-1-1991, by M. DADO

