

FINAL PROOF SURVEY MAP T6N, R35E, WM

APPLICATION NO. G-14326
PERMIT NO. G-13191

FITZGERALD LANE

600

5.0 AC

AUTHORIZED POA

TYPICAL LATERAL


RECEIVED

MAY 19 2004

WATER RESOURCES DEPT
SALEM, OREGON



SCALE: 1 inch = 400 feet

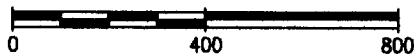

20 21
29 28

SUNNYSIDE-UMAPINE COUNTRY ROAD



5.0 acres in NW 1/4, SW 1/4, S21, T6N, R35E, WM (Tax Lot 600).



Authorized POA, 820 ft South, 1060 ft East from NW 1/4 corner of SW 1/4, Sec 21, T6N, R35E, WM.



3-Inch Buried Mainline W/ 3-Inch Riser Valves



3-Inch Lateral (Aluminum Handline) With Sprinklers

Water beneficially used for irrigating orchard/pasture


Project Name:
Pamela J. Fitzgerald
Milton-Freewater, OR

Date:
10 MAY 2004



Fountainhead Irrigation, Inc.

PO Box 2197 Walla Walla, WA 99362
Phone (509) 529-2646 Fax (509) 522-5251

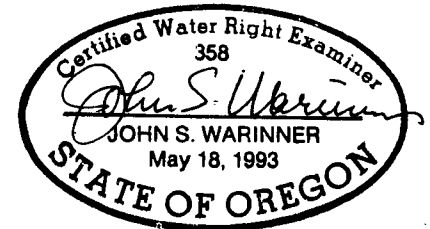

Permittee Signature

Pamela J. Fitzgerald

FINAL PROOF SURVEY MAP

Supplemental Well
IN THE NAME OF
Pamela J. Fitzgerald

Surveyed 10 MAY 2004
by John Warinner, CWRE

do not remove this map from original set