


RECEIVED

MAR 22 2016

By \_\_\_\_\_

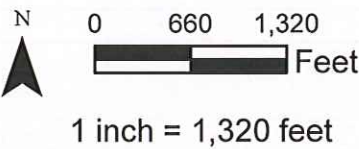

This map is not intended to provide legal dimensions or locations of property ownership lines.

Map revised 3/21/2016

- |   |   |  |
|---|---|--|
| <ul style="list-style-type: none"> <li>■ PODs</li> <li>----- Dirt road</li> <li>----- Ditch</li> <li>— Stream</li> <li>----- Pipeline</li> <li>— Government lot line</li> <li>----- Quarter quarter line</li> <li>— Section line</li> <li>----- Tax lot line</li> </ul> | <p><b>Cert 51105, Priority 1876</b></p> <ul style="list-style-type: none"> <li> From, POD 3</li> <li> Stay, POD 3</li> <li> To, POD 2</li> <li> To, POD 3</li> </ul> <p><b>Cert 51108, Priority 1883</b></p> <ul style="list-style-type: none"> <li> From, POD 1</li> <li> Stay, POD 1</li> <li> To, POD 1</li> </ul> | <p><b>Cert 51109, Priority 2/7/1912</b></p> <ul style="list-style-type: none"> <li> From, POD 1</li> <li> To, POD 2</li> <li> To, POD 4</li> </ul> <p><b>Cert 51082, Priority 8/31/1978</b></p> <ul style="list-style-type: none"> <li> From, POD 2</li> <li> Stay, POD 2</li> <li> To, POD 2</li> <li> To, POD 4</li> </ul> |
|---|---|--|

POD 1 is located in T18S, R41E in the SE NE of section 25; 1,860 feet south and 410 feet west from the NE corner of Section 25.

POD 2 is located in T18S, R41E in the NW SE of corner of Section 26; 1,490 feet north and 2,030 feet west from the SE corner of Section 26.

POD 3 is located in T18S, R41E in the NW NW corner of Section 27; 70 feet east and 60 feet south of the NW corner of section 27.

POD 4 is located in T18S, R41E in the NE NW corner of Section 27; 1,120 feet south and 2,130 feet east from the NW corner of section 27.

Transfer Application Map

Bill and Cindy Romans  
Malheur County, Oregon

Map 2 of 4

map prepared by  
Nancy Rorick Consulting