

- PODs
- ==== Dirt road
- Ditch
- Stream
- Pipeline
- Government lot line
- Quarter quarter line
- Section line
- Tax lot line

Cert 51107, Priority 1886

- From, POD 2
- Stay, POD 2
- To, POD 2

Cert 51081, Priority 11/18/1968

- From, POD 1
- Stay, POD 1
- To, POD 1
- To, POD 2


Map revised 3/21/2016

POD 1 is located in T18S, R41E in the SE NE of section 25; 1,860 feet south and 410 feet west from the NE corner of Section 25.

POD 2 is located in T18S, R41E in the NW SE of corner of Section 26; 1,490 feet north and 2,030 feet west from the SE corner of Section 26.

POD 3 is located in T18S, R41E in the NW NW corner of Section 27; 70 feet east and 60 feet south of the NW corner of section 27.

POD 4 is located in T18S, R41E in the NE NW corner of Section 27; 1,120 feet south and 2,130 feet east from the NW corner of section 27.

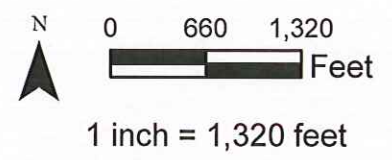

This map is not intended to provide legal dimensions or locations of property ownership lines.



Transfer Application Map
 Bill and Cindy Romans
 Malheur County, Oregon
 Map 4 of 4
 map prepared by
 Nancy Rorick Consulting