


SCALE 1" = 400'

CLAIM OF BENEFICIAL USE
FOR JOESPH AND EVA HOLMES
BY DUANE W. KIRBY
T27S, R6W, SEC 16 WM
APPLICATION NO S-87440
PERMIT NO S-54585
TAX LOT NO 806

FISH SCREEN IS LOCATED AT THE POD
METER IS LOCATED 20 FEET FROM POD

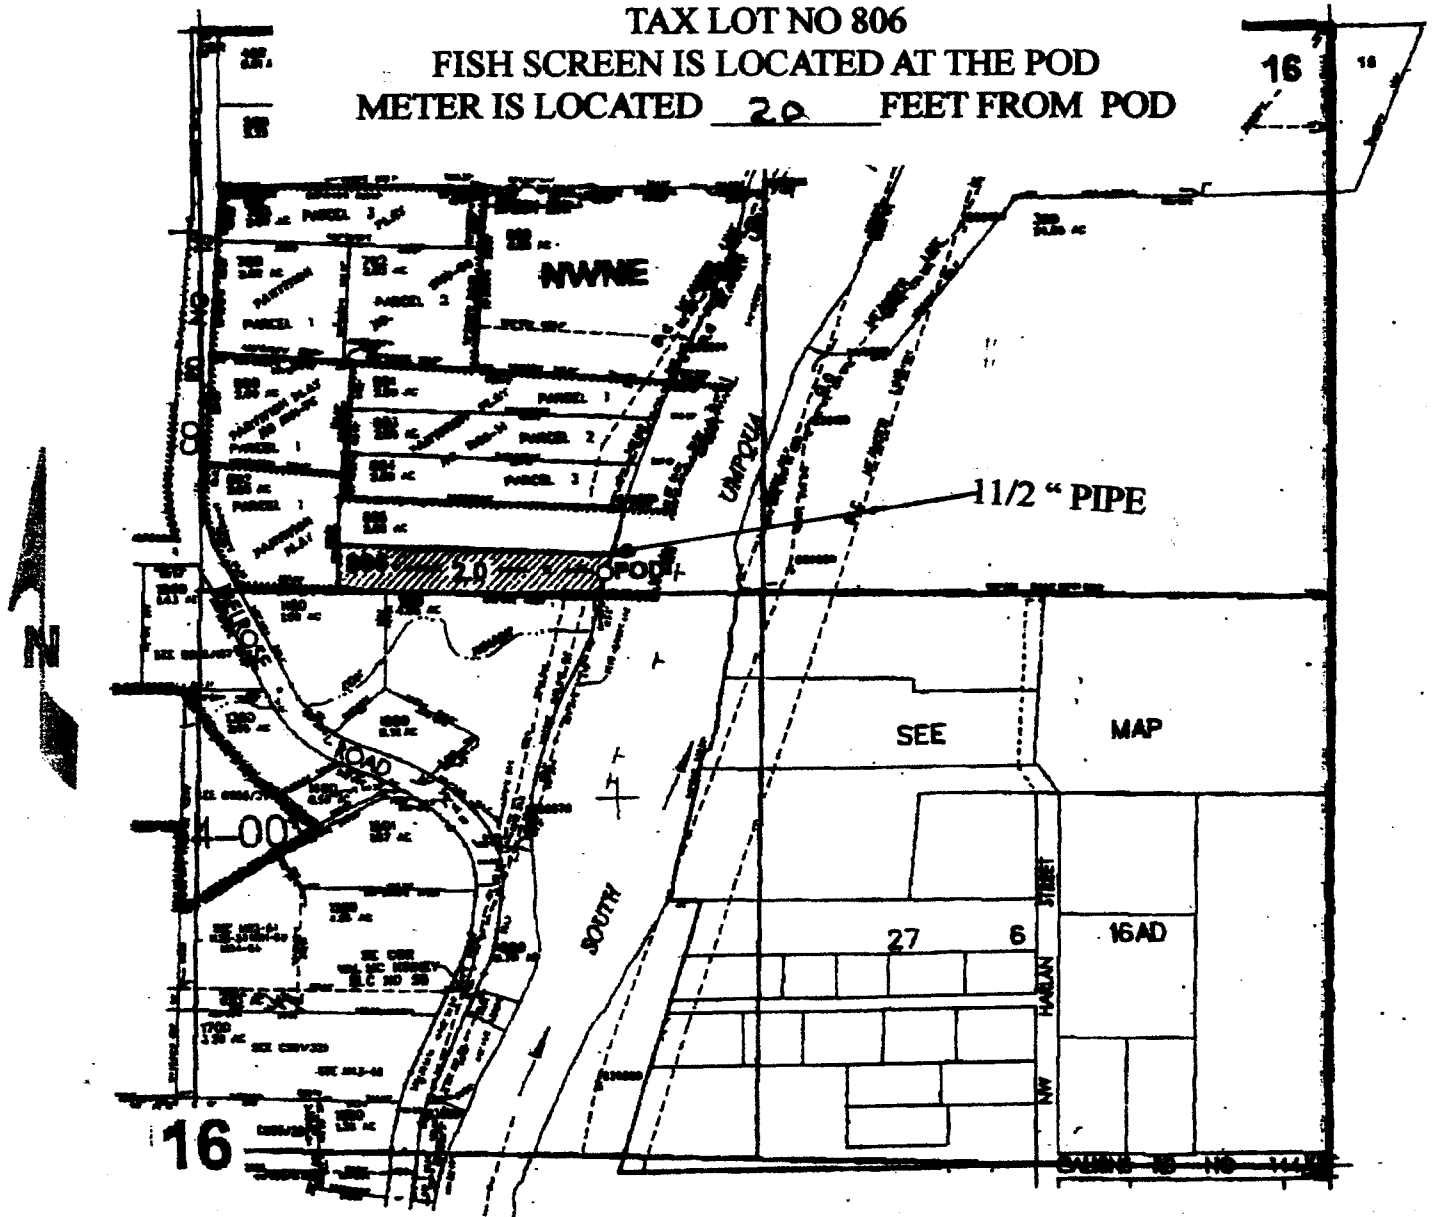

POD is located 1,200 ft. S. and 800 ft. E. from the N1/4 corner of Sec. 16

RECEIVED

MAY 22 2011

THE PURPOSE OF THIS MAP IS TO IDENTIFY THE LOCATION OF THE WATER RIGHT. IT IS NOT INTENDED TO PROVIDE INFORMATION RELATIVE TO THE LOCATION OF PROPERTY OWNERSHIP BOUNDARY LINES.

