


T. 23 S., R. 6 E., W.M.

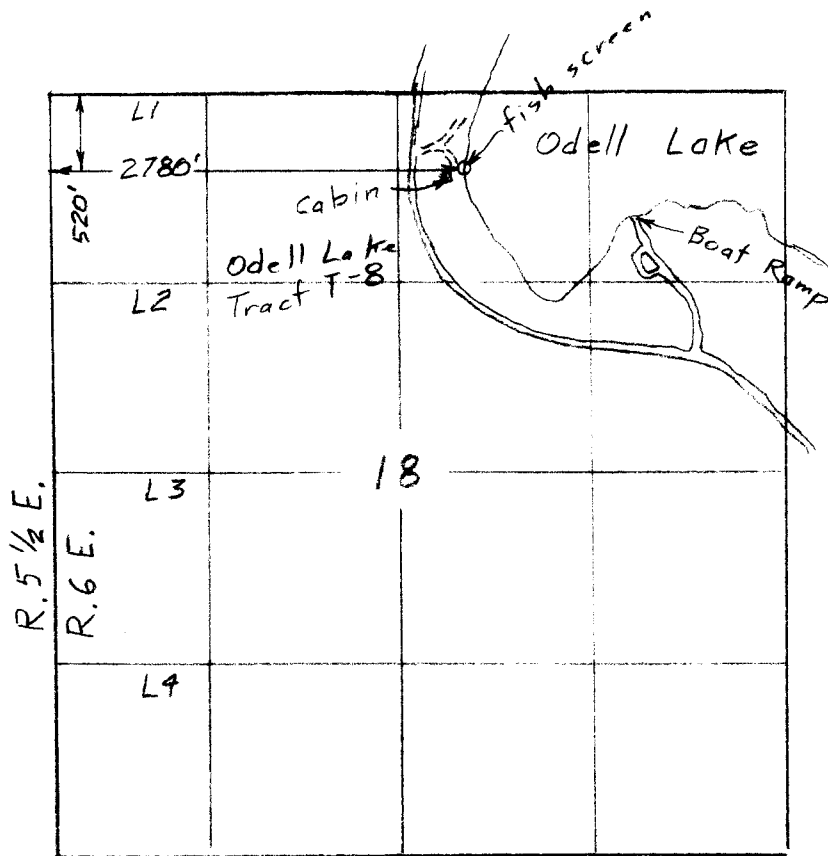

Scale 1" = 1320'
(4" = 1 mile)

flow meter is at NW
corner of cabin

Surveyed Sep. 2, 2010

Claim of Beneficial Use Map
for
Ashley Houghton

Application S-87209
Permit S-54629

MAR 30 2011



This map is for the purpose of
locating a water right only
and has no intent to provide
legal dimensions or the location
of property lines.

ESTES SURVEYS, LLC

PO Box 17810
Salem, OR 97312-0812
(503) 582-3822

80382 Arnold Rd
Salem, OR 97702
(541) 382-7391