

CLAIM OF BENEFICIAL USE MAP

APPLICATION R-84753 PERMIT R-13370

RESERVOIR CONSTRUCTION

FOR

GARVIN FAMILY LLC - VERN R. AND DOROTHY GARVIN


PO BOX 2282

HARBOR, OREGON 97415

SITUATED IN


SECTION 30, TOWNSHIP 35 SOUTH, RANGE 2 WEST, W.M.

JACKSON COUNTY, OREGON

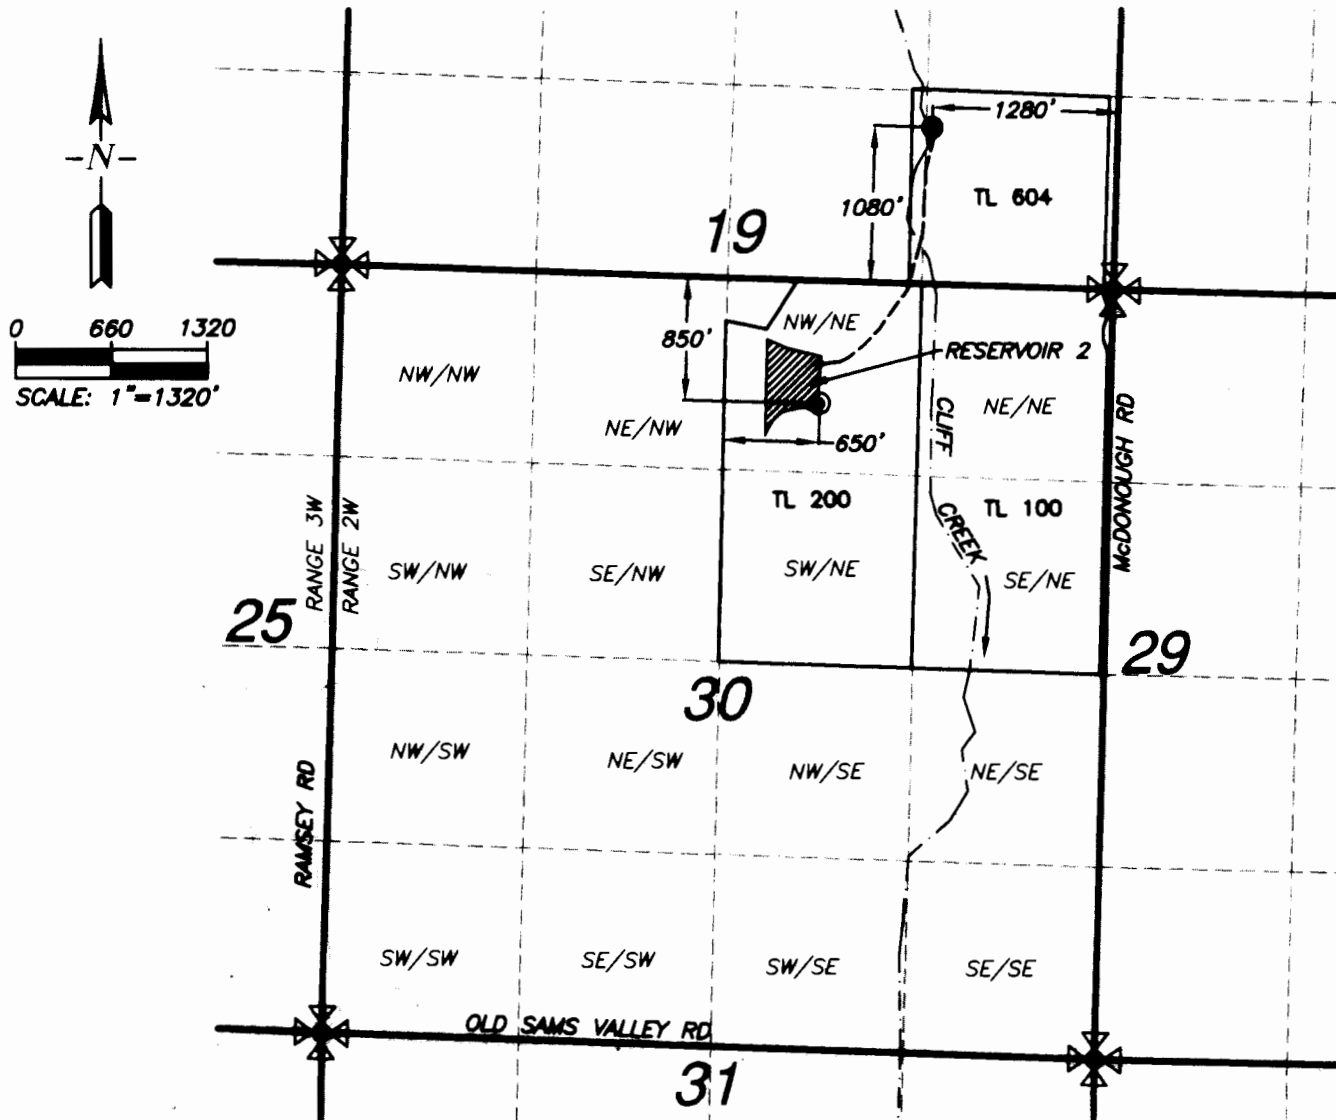

LEGEND

- POINT OF DIVERSION
- ⊙ DAM OUTLET
- 1/4-1/4 SECTION LINE
- RESERVOIR FILL PIPE

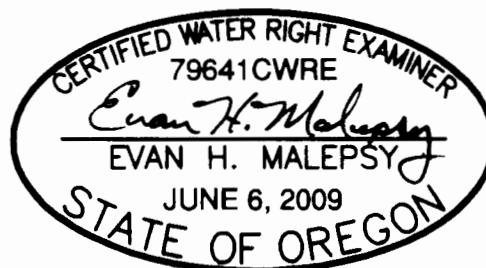

PXX Public Works
Management, Inc.

This map is not intended to provide
legal dimensions or locations of
property ownership lines.

EHM-March 3, 2011

RENEWS: 12/31/2012