


CLAIM OF BENEFICIAL USE MAP
 FOR HORTEN FAMILY TRUST
 LOCATED IN THE NE1/4 OF THE NW1/4 OF SECTION 29,
 TOWNSHIP 23 SOUTH, RANGE 12 WEST, W.M.,
 COOS COUNTY, OREGON

APPLICATION #80439
 PERMIT #52504

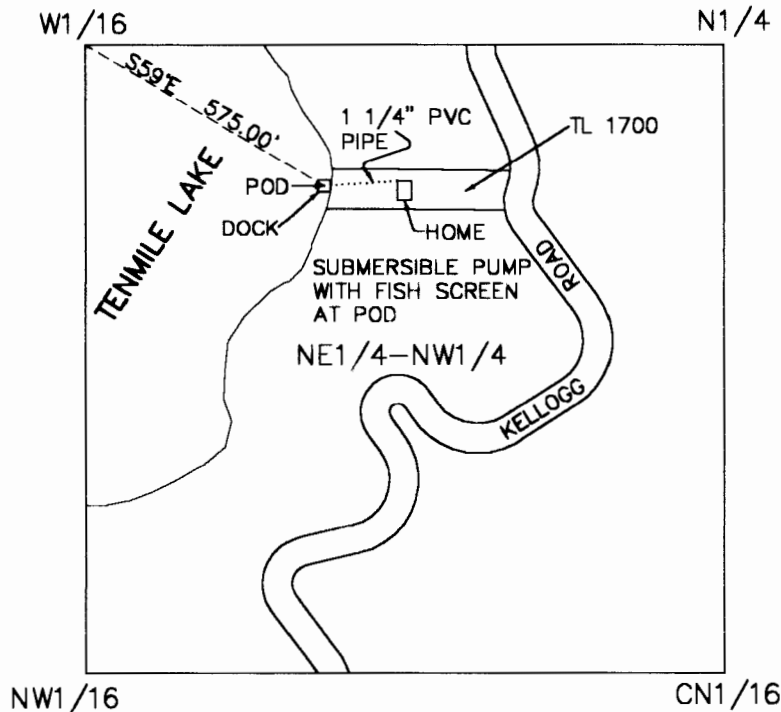

SCALE 1" = 400'



LEGEND:

POD POINT OF DIVERSION

TL TAX LOT

..... WATER PIPE LINE



RECEIVED

EXAMINERS DISCLAIMER STATEMENT:
 THE PREPARATION OF THIS MAP WAS FOR THE PURPOSE OF
 IDENTIFYING THE LOCATION OF WATER RIGHT ONLY AND HAS
 NO INTENT TO PROVIDE DIMENSIONS OR LOCATION OF
 PROPERTY OWNERSHIP LINES.